


KEY PLAN

NOT TO SCALE

DWG D3
DWG D2

DWG D3
DWG D2

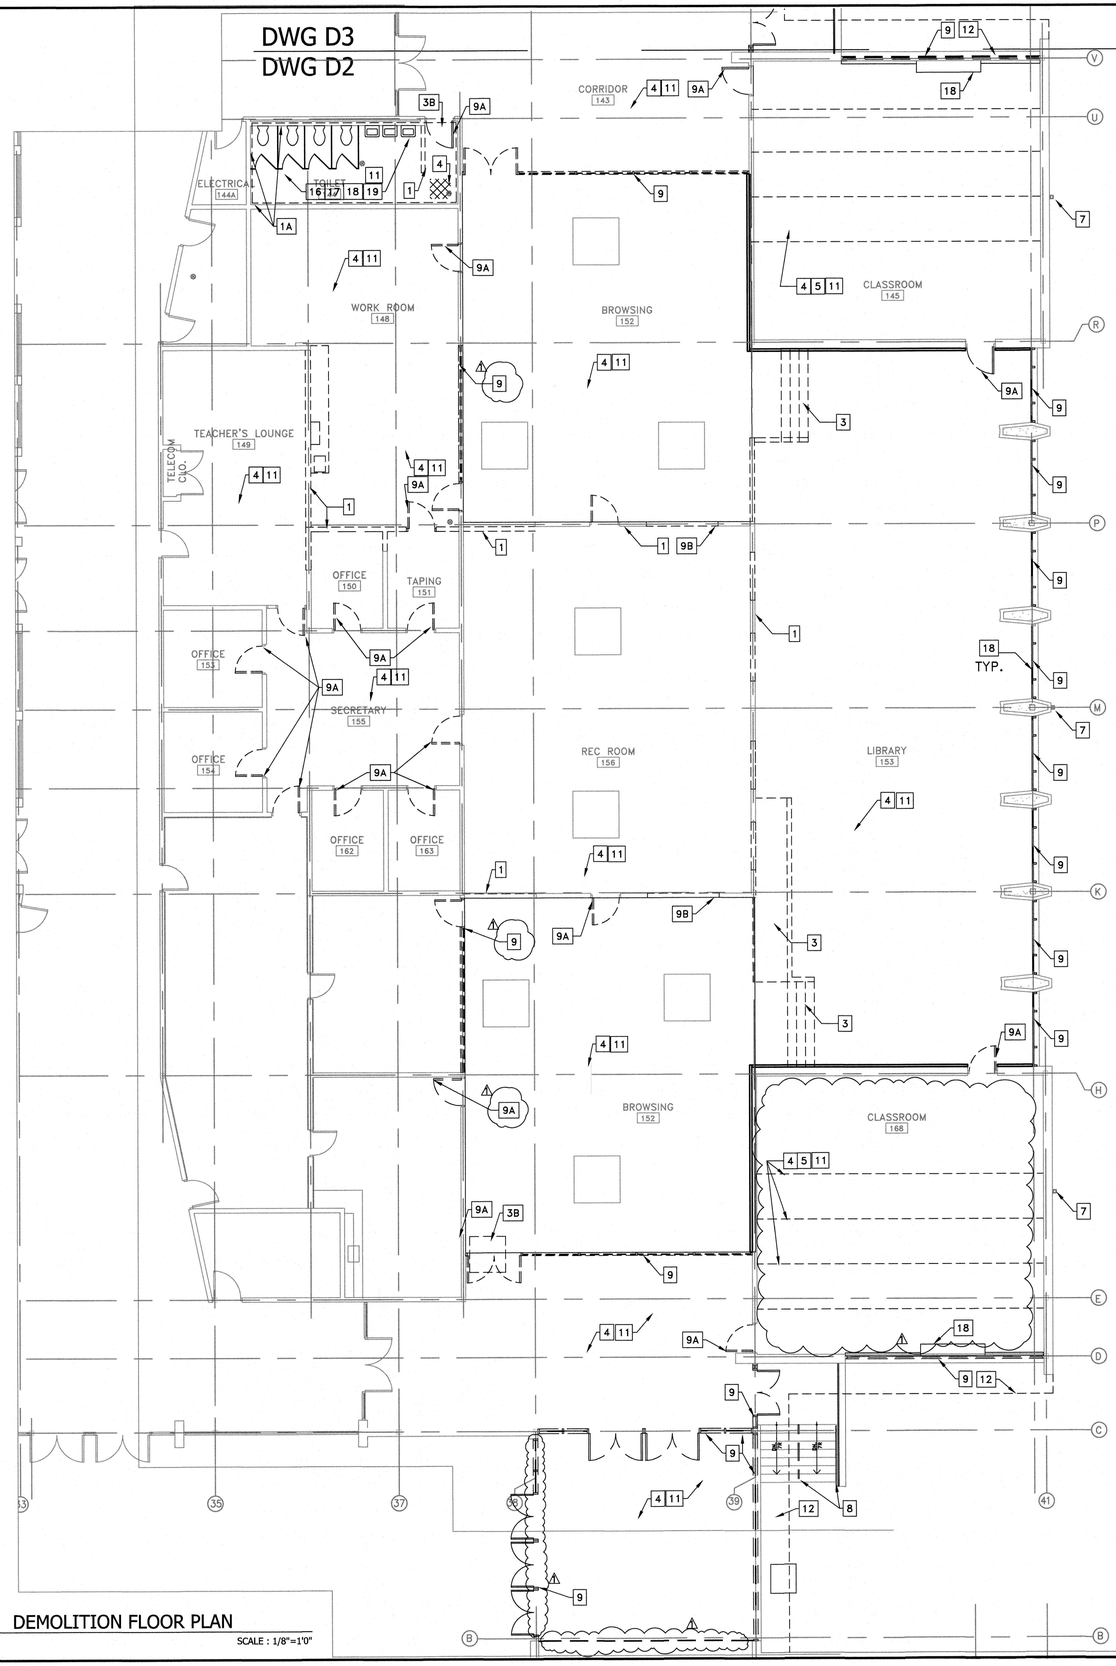

GENERAL NOTES:

1. ALL DIMENSIONS ARE BASED ON EXISTING DRAWINGS.
2. DO NOT MEASURE DRAWINGS, IF THERE IS DISCREPANCY IN DIMENSION, REACH OUT TO ARCHITECT/ENGINEER.

LEGEND

- INDICATE EXIST. WALLS/WINDOWS/DOORS
- INDICATE DEMOLITION

1 DEMOLITION FLOOR PLAN

SCALE : 1/8"=1'0"

DEMOLITION KEY NOTES:

1. DEMOLISH EXISTING WALLS AND PREP FOR NEW WALLS, DOORS, FINISHES AS INDICATED, SEE A AND S SERIES DRAWINGS.

1A. DEMOLISH EXISTING WALL TILES, BASE, PREP WALLS FOR NEW FINISH, DEMOLISH CMU WALL WITH PLUMBING FIXTURE UPTO 3'-0" HIGH.

2. DEMOLISH/SAW CUT EXISTING WALL FOR A NEW DOOR, PASS THRU WINDOW, SEE A AND S SERIES DWGS.

3. DEMOLISH EXISTING CONCRETE AS SHOWN ON DRAWINGS. COORDINATE W/ STRUCTURAL DRAWINGS FOR DEMOLITIONS AND PATCH/REPAIR.

3A DEMOLISH EXISTING PAVER BLOCK/PATIO, PREPARE GRADE FOR NEW PATIO.

3B DEMOLISH EXISTING CONCRETE SLAB, EXCAVATE BELOW SLAB TO CONNECT TO EXISTING SANITARY SEWER PIPES TO A DEPTH AS INDICATED ON PLUMBING AND DEMOLITION DRAWINGS. REFER TO SB FOR MORE INFORMATION ON DEMO AND REPAIR OF CONC. FLOOR SLAB. REFER TO PLUMBING DEMO DRAWINGS FOR ALL LOCATIONS.

4. PATCH, REPAIR, CLEAN, PREPARE CONCRETE FLOOR SUBSTRATE AFTER DEMOLISHING FLOOR FINISHES, TO RECEIVE NEW FLOORING. SEE ROOM FINISH SCHEDULE FOR THE FLOORING FINISHES.

5. DEMOLISH EXISTING PLATFORM CONSISTING OF WOOD/METAL AND OTHER MATERIALS AND PREPARE THE FLOOR SURFACE TO RECEIVE NEW FINISH.

6. DEMOLISH LIMITED AREAS OF ROOFING MEMBRANES, INSULATION AND ALL ITEMS INDICATED TO BE DEMOLISHED TO THE EXISTING ROOF DECK WHERE INDICATED FOR INSTALLATION OF ROOF TOP UNIT. EXISTING SOLAR PANELS, CONDUITS, LIGHTS, DEVICES, LIGHTNING PROTECTION SYSTEM, AND OTHER ITEMS TO REMAIN UNLESS NOTED OTHERWISE. SEE DRAWINGS AND SPECIFICATIONS FOR MORE INFORMATION.

7. EXISTING RAINWATER CONDUCTOR TO REMAIN, PROTECT DURING CONSTRUCTION.

8. DEMOLISH EXISTING HANDRAIL/GUARDRAILS, REMOVE EXISTING FLOOR AND WALL ANCHORS, PATCH AS REQUIRED TO RECEIVE NEW ANCHORS, GUARDRAIL/HANDRAIL SYSTEM AND FINISHES.

9. DEMOLISH EXISTING METAL STOREFRONT/WINDOWS/GLAZED WALL SYSTEM/DOORS AND ALL RELATED TRIMS, PATCH REPAIR TO RECEIVE NEW STOREFRONT/WINDOWS/ GLAZED WALL SYSTEM/DOORS.

9A. DEMOLISH EXISTING DOORS, FRAMES TO REMAIN.

9B. DEMOLISH/CUT OPENING IN WALL FOR NEW WINDOW.

10. CAREFULLY DEMOLISH EXISTING WINDOW PANEL IN THE EXISTING WINDOW WALL/STOREFRONT AT FIRST FLOOR OF SENIOR CENTER WHERE INDICATED, PREP FOR INSTALLATION OF NEW WINDOW/WINDOW PANEL, SEE WINDOW SCHEDULE. ALL WINDOWS, PANELS, EMBEDDED STEEL, FRAME, SUPPORTS AND ANCHORS SHALL REMAIN, UNLESS INDICATED.

11. DEMOLISH EXISTING CEILING, GRID AND SUPPORTS. SEE P, H, E-SERIES DRAWINGS FOR DEMOLITION OF LIGHTS AND OTHER CEILING MOUNTED FIXTURE.

12. DEMOLISH EXISTING SOFFIT AND TRIMS, EXISTING ELECTRICAL DEVICES, CONNECTIONS, WIRING, CONDUITS TO REMAIN, SEE E SERIES DWGS.

13. DEMOLISH EXISTING FLOOR FINISHES AND PREPARE SURFACES FOR NEW FINISHES.

14. RELOCATE EQUIPMENT TO NEW LOCATION, PROVIDE ELECTRICAL CONNECTIONS AND OTHER ACCESSORIES.

15. RELOCATE EXISTING STORAGE CABINETS TO NEW LOCATION AS INDICATED ON DRAWINGS.

15A DEMOLISH EXISTING CASEWORK, BASE/WALL CABINETS, PREPARE WALL/FLOOR FOR NEW WORK/FINISHES.

16. DEMOLISH EXISTING PLUMBING FIXTURE, FITTINGS, ATTACHED PIPES AND VENTS, SEE PLUMBING DRAWINGS.

17. DEMOLISH EXISTING RESTROOM ACCESSORIES LIKE MIRROR, PAPER TOWEL DISPENSER, SOAP DISPENSER AND RELATED ITEMS AT WOMAN'S REST ROOM.

18. DEMOLISH EXISTING BASEBOARD, COVER, SEE MECHANICAL DRAWINGS FOR MORE INFORMATION.

19. WHERE SUPPLY/RETURN REGISTERS, PIPES, LIGHTS, CONDUITS, PLUMBING FIXTURES, ACCESS PANELS AND ALL OTHER ITEMS ON WALLS, FLOORS, CEILING AND RELATED AREAS ARE BEING DEMOLISHED, PATCH, REPAIR, PREPARE CONCRETE / CMU/ MASONRY/ WALLS/ DRYWALL/ CEILING TO RECEIVE NEW PAINT/ FINISHES.

20. CONTRACTOR SHALL COORDINATE WORK OF ALL SUB CONTRCTOR INCLUDING ABATEMENT CONTRACTOR DURING DEMOLITION, AND PROVIDE TEMPORARY COVER OF DEMOLISHED AREAS PER OSHA GUIDELINES AND TO PROTECT THE INTERIOR AND EXTERIOR OF THE BUILDING FROM ELEMENTS.

ISSUED FOR BID-9/25/26

APPROVED
William R. Long
PROFESSIONAL ENGINEER
NEW JERSEY LICENSE NO. 33012

APPROVED
Anita S. Aradhya
REGISTERED ARCHITECT
NEW JERSEY LICENSE NO. 18769

NO.	REVISIONS	DATE	BY
1	ADDENDUM#1	11/13/26	AA

Tri-State Architects, P.C. / Alaimo Group
LIC. 33012
WILLIAM R. LONG, P.E.
LIC. 18769
ANITA S. ARADHYA, R.A.
200 HIGH STREET
MOUNT HOLLY, N.J.

DATE: AUG. 2026
DESIGNED BY: AA
DRAWN BY: AA
CHECKED BY:
DEPT. HEAD:

CLIENT: WILLINGBORO TOWNSHIP
PROJECT LOCATION: WILLINGBORO TWP. BURLINGTON COUNTY NEW JERSEY
PROJECT NO.: M-0410-0011-000
CONTRACT NO.: BID#8-2026

KENNEDY CENTER
RENOVATION TO THE SENIOR CENTER


DEMOLITION PLAN
SENIOR CENTER (PARTIAL)

SCALE: AS NOTED

SHEET
D2


FILE NO.:

Plotted: 11/11/2026 10:11 AM Last saved: 11/11/2026 10:09 AM File Name: W:\Projects\W0410001100\Drawings\GLO-D2-D3-FloorPlan.dwg

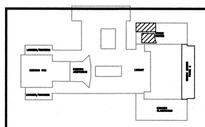

KEY PLAN

NOT TO SCALE

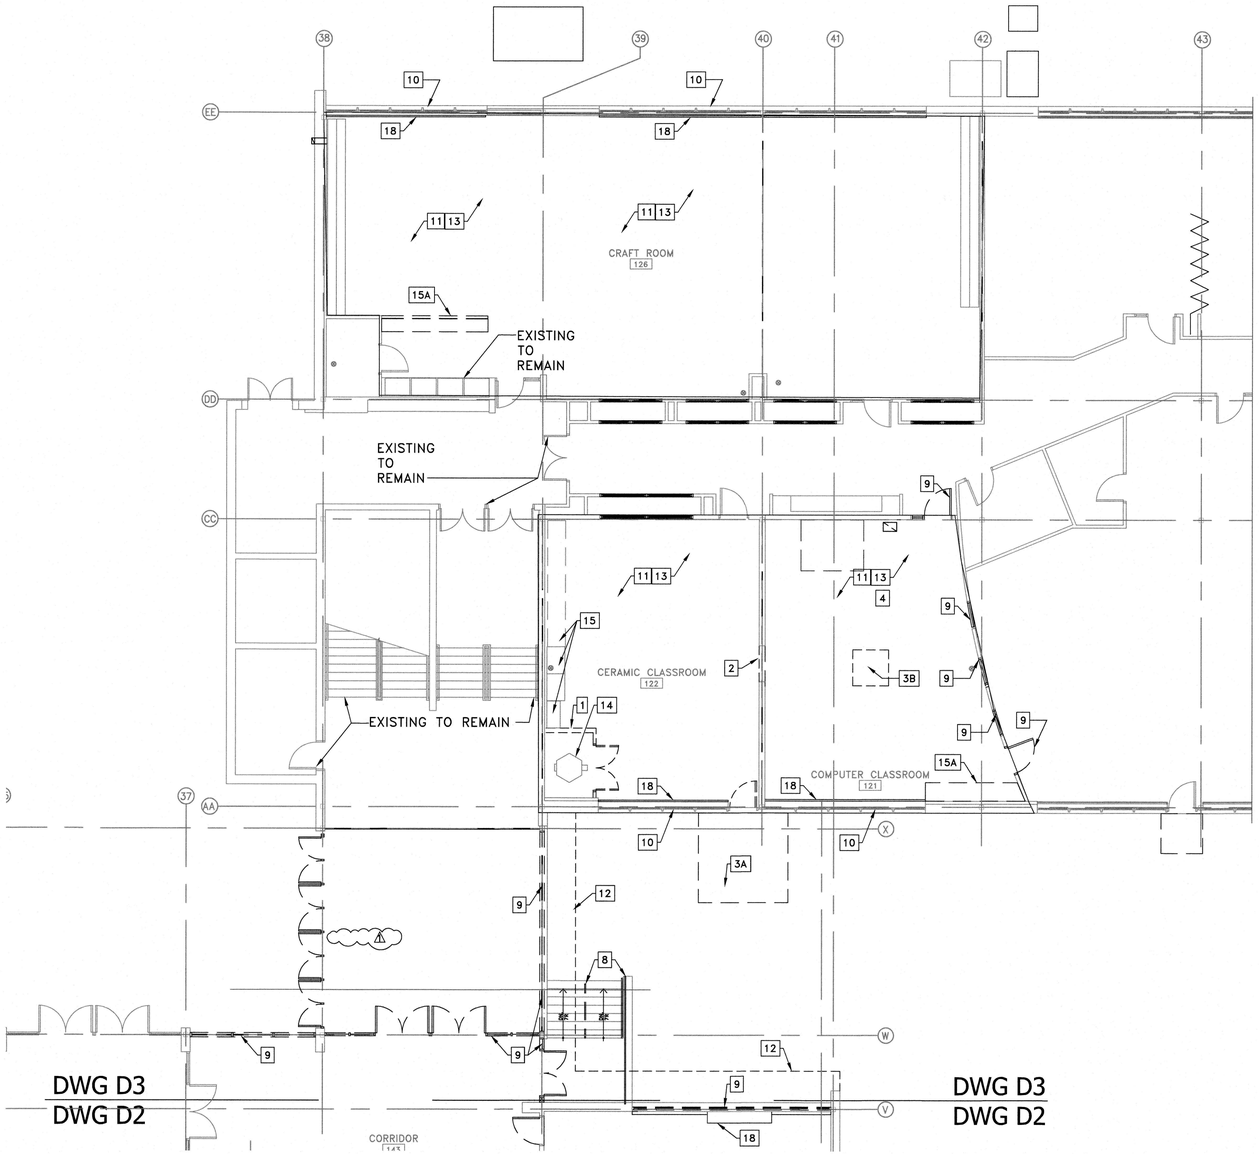

1 DEMOLITION FLOOR PLAN

SCALE : 1/8"=1'0"

GENERAL NOTES:

1. ALL DIMENSIONS ARE BASED ON EXISTING DRAWINGS.
2. DO NOT MEASURE DRAWINGS, IF THERE IS DISCREPANCY IN DIMENSION, REACH OUT TO ARCHITECT/ENGINEER.

LEGEND

- INDICATE EXIST. WALLS/WINDOWS/DOORS
- INDICATE DEMOLITION

DEMOLITION KEY NOTES:

1. DEMOLISH EXISTING WALLS AND PREP FOR NEW WALLS, DOORS, FINISHES AS INDICATED, SEE A AND S SERIES DRAWINGS.

1A. DEMOLISH EXISTING WALL TILES, BASE, PREP WALLS FOR NEW FINISH. DEMOLISH CMU WALL WITH PLUMBING FIXTURE UPTO 3'-0" HIGH. (1)

2. DEMOLISH/SAW CUT EXISTING WALL FOR A NEW DOOR, PASS THRU WINDOW, SEE A AND S SERIES DWGS.

3. DEMOLISH EXISTING CONCRETE AS SHOWN ON DRAWINGS. COORDINATE W/ STRUCTURAL DRAWINGS FOR DEMOLITIONS AND PATCH/REPAIR.

3A DEMOLISH EXISTING PAVER BLOCK/PATIO, PREPARE GRADE FOR NEW PATIO.

3B DEMOLISH EXISTING CONCRETE SLAB, EXCAVATE BELOW SLAB TO CONNECT TO EXISTING SANITARY SEWER PIPES TO A DEPTH AS INDICATED ON PLUMBING AND DEMOLITION DRAWINGS. REFER TO S8 FOR MORE INFORMATION ON DEMO AND REPAIR OF CONC. FLOOR SLAB. REFER TO PLUMBING DEMO DRAWINGS FOR ALL LOCATIONS.

4. PATCH, REPAIR, CLEAN, PREPARE CONCRETE FLOOR SUBSTRATE AFTER DEMOLISHING FLOOR FINISHES, TO RECEIVE NEW FLOORING. SEE ROOM FINISH SCHEDULE FOR THE FLOORING FINISHES.

5. DEMOLISH EXISTING PLATFORM CONSISTING OF WOOD/METAL AND OTHER MATERIALS AND PREPARE THE FLOOR SURFACE TO RECEIVE NEW FINISH.

6. DEMOLISH LIMITED AREAS OF ROOFING MEMBRANES, INSULATION AND ALL ITEMS INDICATED TO BE DEMOLISHED TO THE EXISTING ROOF DECK WHERE INDICATED FOR INSTALLATION OF ROOF TOP UNIT. EXISTING SOLAR PANELS, CONDUITS, LIGHTS, DEVICES, LIGHTNING PROTECTION SYSTEM, AND OTHER ITEMS TO REMAIN UNLESS NOTED OTHERWISE. SEE DRAWINGS AND SPECIFICATIONS FOR MORE INFORMATION.

7. EXISTING RAINWATER CONDUCTOR TO REMAIN, PROTECT DURING CONSTRUCTION.

8. DEMOLISH EXISTING HANDRAIL/GUARDRAILS, REMOVE EXISTING FLOOR AND WALL ANCHORS, PATCH AS REQUIRED TO RECEIVE NEW ANCHORS, GUARDRAIL/HANDRAIL SYSTEM AND FINISHES.

9. DEMOLISH EXISTING METAL STOREFRONT/WINDOWS/GLAZED WALL SYSTEM/DOORS AND ALL RELATED TRIMS, PATCH REPAIR TO RECEIVE NEW STOREFRONT/WINDOWS/ GLAZED WALL SYSTEM/DOORS.

9A. DEMOLISH EXISTING DOORS, FRAMES TO REMAIN.

9B. DEMOLISH/CUT OPENING IN WALL FOR NEW WINDOW.

10. CAREFULLY DEMOLISH EXISTING WINDOW PANEL IN THE EXISTING WINDOW WALL/STOREFRONT AT FIRST FLOOR OF SENIOR CENTER WHERE INDICATED, PREP FOR INSTALLATION OF NEW WINDOW/WINDOW PANEL, SEE WINDOW SCHEDULE. ALL WINDOWS, PANELS, EMBEDDED STEEL, FRAME, SUPPORTS AND ANCHORS SHALL REMAIN, UNLESS INDICATED.

11. DEMOLISH EXISTING CEILING, GRID AND SUPPORTS. SEE P, H, E-SERIES DRAWINGS FOR DEMOLITION OF LIGHTS AND OTHER CEILING MOUNTED FIXTURE.

12. DEMOLISH EXISTING SOFFIT AND TRIMS, EXISTING ELECTRICAL DEVICES, CONNECTIONS, WIRING, CONDUITS TO REMAIN, SEE E SERIES DWGS.

13. DEMOLISH EXISTING FLOOR FINISHES AND PREPARE SURFACES FOR NEW FINISHES.

14. RELOCATE EQUIPMENT TO NEW LOCATION, PROVIDE ELECTRICAL CONNECTIONS AND OTHER ACCESSORIES.

15. RELOCATE EXISTING STORAGE CABINETS TO NEW LOCATION AS INDICATED ON DRAWINGS.

15A DEMOLISH EXISTING CASEWORK, BASE/WALL CABINETS, PREPARE WALL/FLOOR FOR NEW WORK/FINISHES.

16. DEMOLISH EXISTING PLUMBING FIXTURE, FITTINGS, ATTACHED PIPES AND VENTS, SEE PLUMBING DRAWINGS.

17. DEMOLISH EXISTING RESTROOM ACCESSORIES LIKE MIRROR, PAPER TOWEL DISPENSER, SOAP DISPENSER AND RELATED ITEMS AT WOMAN'S REST ROOM.

18. DEMOLISH EXISTING BASEBOARD, COVER, SEE MECHANICAL DRAWINGS FOR MORE INFORMATION.

19. WHERE SUPPLY/RETURN REGISTERS, PIPES, LIGHTS, CONDUITS, PLUMBING FIXTURES, ACCESS PANELS AND ALL OTHER ITEMS ON WALLS, FLOORS, CEILING AND RELATED AREAS ARE BEING DEMOLISHED, PATCH, REPAIR, PREPARE CONCRETE / CMU/ MASONRY/ WALLS/ DRYWALL/ CEILING TO RECEIVE NEW PAINT/ FINISHES.

20. CONTRACTOR SHALL COORDINATE WORK OF ALL SUB CONTRCTOR INCLUDING ABATEMENT CONTRACTOR DURING DEMOLITION, AND PROVIDE TEMPORARY COVER OF DEMOLISHED AREAS PER OSHA GUIDELINES AND TO PROTECT THE INTERIOR AND EXTERIOR OF THE BUILDING FROM ELEMENTS. (1)

ISSUED FOR BID-9/25/26

APPROVED
11.12.26
William R. Long
PROFESSIONAL ENGINEER
NEW JERSEY LICENSE NO. 33012

APPROVED
Anita S. Aradhya
REGISTERED ARCHITECT
NEW JERSEY LICENSE NO. 18769

REVISIONS	DATE	BY
1 ADDENDUM#5	11/12/26	AA

Tri-State Architects, P.C. / Alaimo Group
LIC. 33012 WILLIAM R. LONG, P.E.
LIC. 18769 ANITA S. ARADHYA, R.A.
200 HIGH STREET MOUNT HOLLY, N.J.

DATE: AUG. 2026
DESIGNED BY: AA
DRAWN BY: AA
CHECKED BY:
DEPT. HEAD:

CLIENT: WILLINGBORO TOWNSHIP
PROJECT LOCATION: WILLINGBORO TWP., BURLINGTON COUNTY NEW JERSEY
PROJECT NO.: M-0410-0011-000
CONTRACT NO.: BID#8-2026

KENNEDY CENTER
RENOVATION TO THE SENIOR CENTER


DEMOLITION FLOOR PLAN
SENIOR CENTER (PARTIAL)

SCALE: AS NOTED

SHEET
D3


FILE NO.:

Plotted: 11/11/2026 10:10 AM Last saved: 11/11/2026 10:09 AM File Name: M:\Projects\M0410001\000\Drawings\GLG-02-D3-FloorPlan.dwg

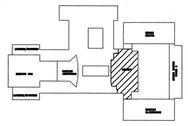

KEY PLAN

NOT TO SCALE

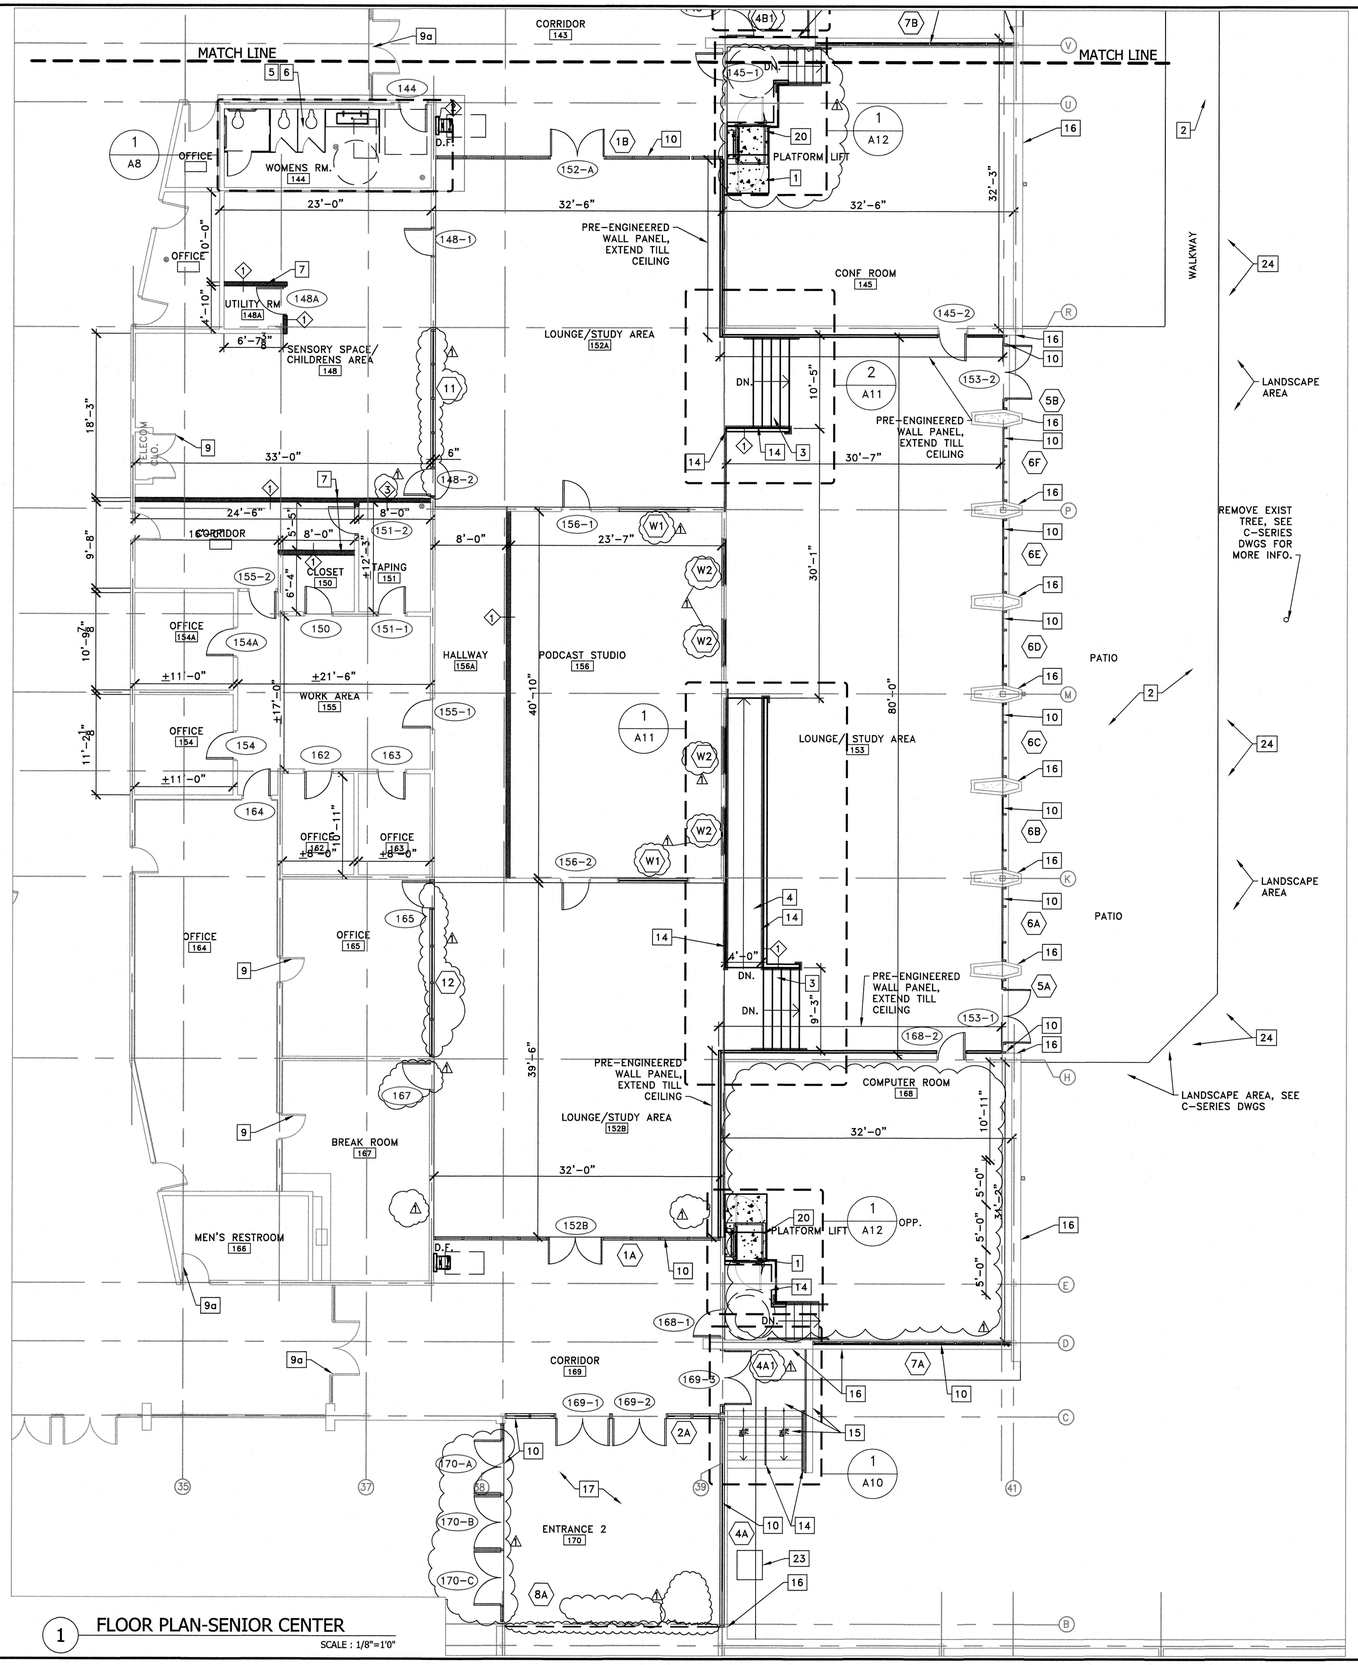

1 FLOOR PLAN-SENIOR CENTER

SCALE : 1/8"=1'0"

0 4' 8' 16'

SCALE: 1/8" = 1'-0"

ISSUED FOR BID-9/25/26

GENERAL NOTES:

A. REFER TO SHEET G3 FOR GENERAL NOTES, LEGENDS AND ABBREVIATION.

B. CONTRACTOR SHALL VERIFY ALL EXISTING CONDITIONS PRIOR TO START OF WORK AND ORDERING MATERIALS; AND DISCREPANCY IF ANY SHALL BE BROUGHT TO THE NOTICE OF ARCHITECT/ENGINEER.

C. ALL DRAWINGS ARE BASED ON EXISTING BUILDING SURVEY AND EXISTING DRAWINGS BY ARCHITECTS, KIMMEL BORGETTE PHILADELPHIA PA, DATED 2013, AND DMR AND REMINGTON VERNICK, NEW JERSEY DATED 2009. CONTRACTOR SHALL VERIFY ALL DIMENSIONS AT SITE AND BRING TO ATTENTION OF ARCHITECTS/ ENGINEERS PRIOR TO START OF WORK.

E ALL DOORS, OVERHEAD DOORS, WINDOWS SHALL HAVE SAME FIRE RATING AS THE RESPECTIVE WALLS THEY ARE LOCATED AT.

F ALL PIPE, DUCT, CONDUIT PENETRATION, PIPE SUPPORTS THRU WALLS AND ANY OTHER PENETRATIONS IN FIRE RATED WALL SHALL BE SEALED WITH FIRE STOP, INSTALLED WITH FIRE DAMPERS AS APPROPRIATE. FIRE DAMPER, FIRE STOP RATING SHALL MATCH THE FIRE RATING OF THE WALLS THEY ARE LOCATED AT.

G MARKING AND IDENTIFICATION OF FIRE RATED WALLS:

1 WHERE THERE IS ACCESSIBLE CONCEALED FLOOR, FLOOR–CEILING OR ATTIC SPACE, FIRE WALLS, FIRE BARRIERS FIRE PARTITIONS OR ANY OTHER WALL REQUIRED TO HAVE PROTECTED OPENINGS AND PENETRATIONS SHALL BE EFFECTIVELY AND PERMANENTLY IDENTIFIED WITH SIGNS OR STENCILING IN THE CONCEALED SPACE. SUCH IDENTIFICATION SHALL:

2 BE LOCATED WITHIN 15 FEET OF THE END OF EACH WALL AND AT INTERVALS NOT EXCEEDING 30 FEET MEASURED HORIZONTALLY ALONG THE WALL OR PARTITION.

3 INCLUDE LETTERING NOT LESS THAN 3 INCHES IN HEIGHT AND WITH A MINIMUM 3/8 INCH STROKE IN A CONTRAST COLOR INCORPORATING THE SUGGESTED WORDING, "FIRE BARRIER–PROTECT ALL OPENINGS" OR OTHER WORDING.

4 GLAZING MARKING IN FIRE RATED WINDOWS AND DOORS AS APPLICABLE:
DOORS – XX MINS. – D–H–XX
WINDOWS–XX MINS. – OH–XX

LEGEND:

ROOM NAME 100	ROOM NAME & NUMBER SEE DWG A20 FOR ROOM FINISH SCHEDULE
D01	DOOR NUMBER SEE DWG A–19 FOR DOOR SCHEDULE
W	WINDOW/STOREFRONT TYPE SEE DWG A16 FOR DETAILS
1	WALL TYPE, SEE DWG A–15
F.E.	FIRE EXTINGUISHER, U.L. RATING 4A–80B:C MOUNTED 4'–0" A.F.F.; SEE SPECS.
×––.00	FINISHED FLOOR ELEVATION
R.O.	ROUGH OPENING
	SLOPE
F.D.	FLOOR DRAIN: SEE P–SERIES DWGS. FOR SIZE
C.O.	CLEAN OUT; SEE P–SERIES DWGS. FOR SIZE
	ADA CLEARANCE REQUIREMENT
	INDICATE EXIST. WALLS/WINDOWS/DOORS
	INDICATE NEW CONSTRUCTION

KEY NOTES:

1. CONC FLOOR SLAB, SEE S–SERIES DWGS.
2. CONC PATIO, SEE C AND S SERIES DWGS.
3. CONC STEPS, SEE S SERIES DWGS.
4. CONC RAMP, SEE S SERIES DWGS.
5. REPAIR EXISTING SLAB AFTER FLOOR DRAINS, PIPING, AND OTHER ITEMS AT/UNDER FLOOR SLAB IS DEMOLISHED OR INSTALLED AS INDICATED ON DRAWINGS.
6. REPAIR EXISTING CHASE WALL AFTER NEW PLUMBING FIXTURE AND PIPING IS INSTALLED.
7. METAL STUD WALLS, SEE A–SERIES DWGS.
7A. METAL STUD WALLS, FIRE RATED, SEE A–SERIES DWGS.
8. INSTALL ROOF CURB, FLASHING, ROOFING MEMBRANE, INSULATION AT NEW ROOF TOP EQUIPMENT AND VENTS.
9. EXISTING DOOR TO REMAIN, PAINT/FINISH AS INDICATED ON ROOM FINISH SCHEDULE.
9a. EXISTING DOOR TO REMAIN.
10. ALUM STOREFRONT/WINDOW/GLAZED WALL/ENTRANCE, SEE DOOR SCHEDULE.
11. EXISTING WINDOW WALL/STOREFRONT TO REMAIN.
12. EXISTING WINDOW WALL/STOREFRONT TO REMAIN, REPLACE WINDOW AND PANELS WHERE INDICATED, CLEAN EXISTING ALUM FRAMES, INSTALL SEALANT AT THE JOINT BETWEEN WALL AND FRAME AND WHERE REQUIRED, FINISH PER DOOR AND WINDOW SCHEDULE.
13. PASS THRU WINDOW, SEE A–SERIES DWGS. FOR DETAILS.
14. 1 1/2" DIA. ANODIZED ALUM HANDRAIL AND GUARD RAIL, WITH VERTICAL SUPPORTS NOT EXCEEDING 4'–0" O.C. PATCH/ REPAIR WALLS AND CONC CURB/FLOOR AS REQUIRED AFTER INSTALLING ANCHORS. SEE SPECIFICATIONS FOR MORE INFO.
15. EXTERIOR CONCRETE STEPS AND LANDING AT COURTYARD SHALL BE REPAIRED, CRACKS AND SPALLS PATCHED AND SURFACE CLEANED TO REMOVE DISCOLORATION. ALL JOINTS BETWEEN CONCRETE AND EXISTING BUILDING WALLS SHALL BE SEALED WITH ELASTOMERIC SEALANT, SEE SPECIFICATIONS. SEE S SERIES DWGS FOR CONC REPAIR DETAILS.
16. AT BRICK WALLS; CLEAN, REMOVE STAINS, REPOINT MISSING MORTAR JOINTS, REPAIR SPALLS, REMOVE AND REPLACE DAMAGED BRICKS, SEE SPECIFICATIONS.
17. SEE ROOM FINISH SCHEDULE FOR ALL FINISHES.
18. INSTALL CABINETS/ KITCHEN FURNITURE/ SHELVES/OTHER RELATED ITEMS; SEE DETAIL DRAWINGS.
19. INSTALL RELOCATED FURNITURE, CASEWORK AND EQUIPMENT.
20. PLATFORM LIFT, SEE A, S, E–SERIES DRAWINGS.
21. KITCHEN HOOD AND FIRE SAFETY SYSTEM, SEE A, P, E, H–SERIES DWGS.
22. VERTICAL CHASE FOR SUPPLY/EXHAUST HOOD, SEE H SERIES DWGS FOR SIZE, EXTEND THE CHASE WALLS THRU FIRST FLOOR CEILING, SECOND FLOOR AND TO THE ROOF.
AT SECOND FLOOR VERIFY THE LOCATION WITH EXISTING WALL, STRUCTURAL COMPONENTS AND OTHER EXISTING ITEMS, BEFORE CUTTING OPENING AND CONSTRUCTING THE CHASE WALLS. IF ANY DISCREPANCY OCCURS REACH OUT TO ARCHITECT/ENGINEER AND OWNER. ALL WORK RELATED TO THE CONSTRUCTION OF CHASE IS PART OF THIS WORK, NO ADDITIONAL PAYMENT WILL BE MADE, CONTRACTORS SHALL VERIFY EXISTING CONDITIONS DURING PRE–BID SITE VISIT.
23. MECHANICAL EQUIPMENT PAD, SEE H, S SERIES DWGS.
24. LANDSCAPE DETAILS, SEE C SERIES DWGS.

APPROVED 11-12-26
William R. Long
PROFESSIONAL ENGINEER
NEW JERSEY LICENSE NO. 33012

APPROVED
Anita S. Aradhya
REGISTERED ARCHITECT
NEW JERSEY LICENSE NO. 18769

REVISIONS	DATE	BY
1 ADDENDUM#5	11/12/26	AA

Tri-State Architects, P.C. / Alaimo Group
LIC. 33012
LIC. 18769
WILLIAM R. LONG, P.E.
ANITA S. ARADHYA, R.A.
200 HIGH STREET
MOUNT HOLLY, N.J.

DATE: AUG. 2026
DESIGNED BY: AA
DRAWN BY: AA
CHECKED BY:
DEPT. HEAD:

CLIENT: WILLINGBORO TOWNSHIP
PROJECT NO.: M-0410-0011-000
CONTRACT NO.: BID#8-2026
PROJECT LOCATION: WILLINGBORO TWP. BURLINGTON COUNTY NEW JERSEY

KENNEDY CENTER
RENOVATION TO THE SENIOR CENTER

FLOOR PLAN
SENIOR CENTER

SCALE: AS NOTED


SHEET
A2

FILE NO.:

Plotted: 11/11/2026 10:12 AM Last saved: 11/10/2026 2:12 PM File Name: W:\Projects\M0410001000\Drawings\Gld–A2–A3–FloorPlan.dwg

KEY PLAN

NOT TO SCALE

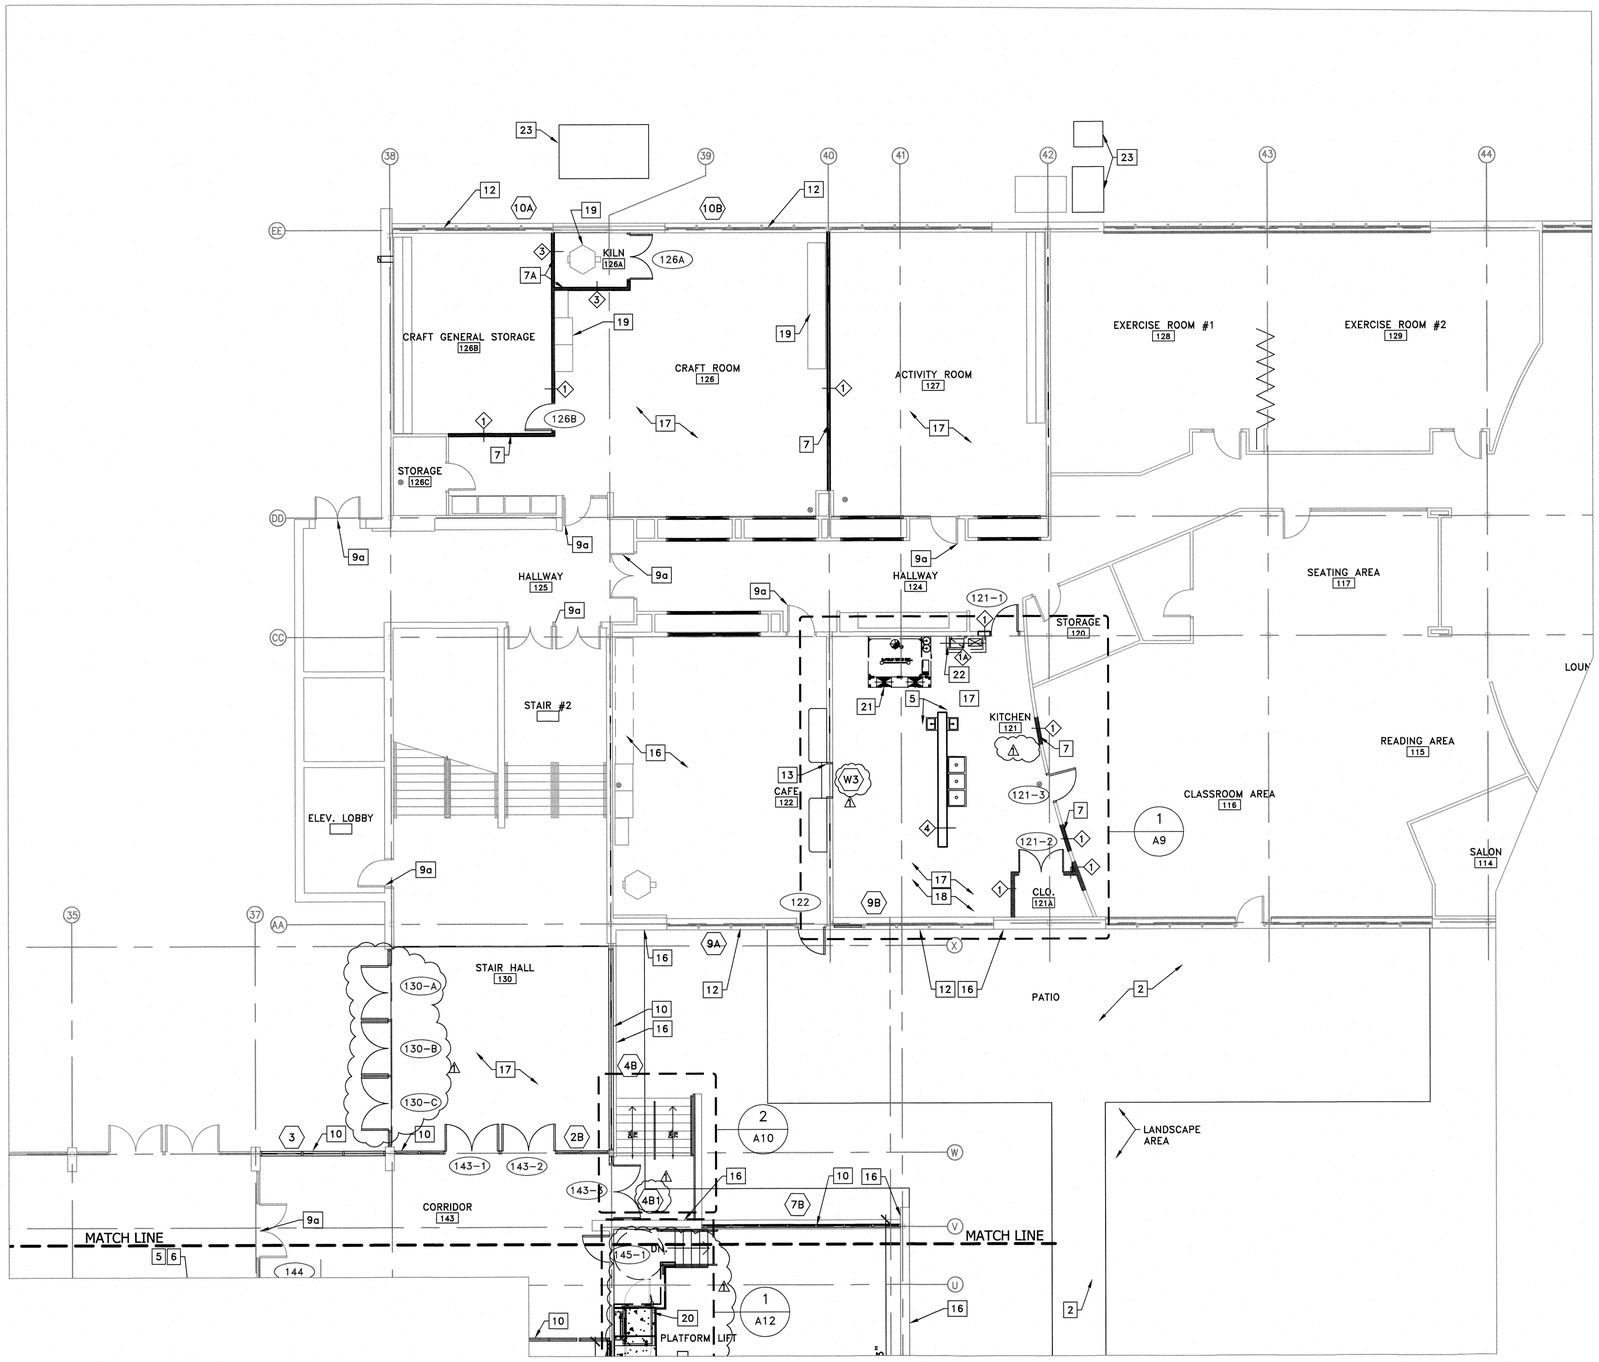

1 FLOOR PLAN-SENIOR CENTER

SCALE : 1/8"=1'0"

GENERAL NOTES:

A. REFER TO SHEET G3 FOR GENERAL NOTES, LEGENDS AND ABBREVIATION.

B. CONTRACTOR SHALL VERIFY ALL EXISTING CONDITIONS PRIOR TO START OF WORK AND ORDERING MATERIALS; AND DISCREPANCY IF ANY SHALL BE BROUGHT TO THE NOTICE OF ARCHITECT/ENGINEER.

C. ALL DRAWINGS ARE BASED ON EXISTING BUILDING SURVEY AND EXISTING DRAWINGS BY ARCHITECTS, KIMMEL BORGETTE PHILADELPHIA PA, DATED 2013, AND DMR AND REMINGTON VERNICK, NEW JERSEY DATED 2009. CONTRACTOR SHALL VERIFY ALL DIMENSIONS AT SITE AND BRING TO ATTENTION OF ARCHITECTS/ ENGINEERS PRIOR TO START OF WORK.

E ALL DOORS, OVERHEAD DOORS, WINDOWS SHALL HAVE SAME FIRE RATING AS THE RESPECTIVE WALLS THEY ARE LOCATED AT.

F ALL PIPE, DUCT, CONDUIT PENETRATION, PIPE SUPPORTS THRU WALLS AND ANY OTHER PENETRATIONS IN FIRE RATED WALL SHALL BE SEALED WITH FIRE STOP, INSTALLED WITH FIRE DAMPERS AS APPROPRIATE. FIRE DAMPER, FIRE STOP RATING SHALL MATCH THE FIRE RATING OF THE WALLS THEY ARE LOCATED AT.

G MARKING AND IDENTIFICATION OF FIRE RATED WALLS:

1 WHERE THERE IS ACCESSIBLE CONCEALED FLOOR, FLOOR–CEILING OR ATTIC SPACE, FIRE WALLS, FIRE BARRIERS FIRE PARTITIONS OR ANY OTHER WALL REQUIRED TO HAVE PROTECTED OPENINGS AND PENETRATIONS SHALL BE EFFECTIVELY AND PERMANENTLY IDENTIFIED WITH SIGNS OR STENCILING IN THE CONCEALED SPACE. SUCH IDENTIFICATION SHALL:

2 BE LOCATED WITHIN 15 FEET OF THE END OF EACH WALL AND AT INTERVALS NOT EXCEEDING 30 FEET MEASURED HORIZONTALLY ALONG THE WALL OR PARTITION.

3 INCLUDE LETTERING NOT LESS THAN 3 INCHES IN HEIGHT AND WITH A MINIMUM 3/8 INCH STROKE IN A CONTRAST COLOR INCORPORATING THE SUGGESTED WORDING, "FIRE BARRIER–PROTECT ALL OPENINGS" OR OTHER WORDING.

4 GLAZING MARKING IN FIRE RATED WINDOWS AND DOORS AS APPLICABLE:
DOORS – XX MINS. – D–H–XX
WINDOWS–XX MINS. – OH–XX

KEY NOTES:

1. CONC FLOOR SLAB, SEE S–SERIES DWGS.
2. CONC PATIO, SEE C AND S SERIES DWGS.
3. CONC STEPS, SEE S SERIES DWGS.
4. CONC RAMP, SEE S SERIES DWGS.
5. REPAIR EXISTING SLAB AFTER FLOOR DRAINS, PIPING, AND OTHER ITEMS AT/UNDER FLOOR SLAB IS DEMOLISHED OR INSTALLED AS INDICATED ON DRAWINGS.
6. REPAIR EXISTING CHASE WALL AFTER NEW PLUMBING FIXTURE AND PIPING IS INSTALLED.
7. METAL STUD WALLS, SEE A–SERIES DWGS.

7A. METAL STUD WALLS, FIRE RATED, SEE A–SERIES DWGS.

8. INSTALL ROOF CURB, FLASHING, ROOFING MEMBRANE, INSULATION AT NEW ROOF TOP EQUIPMENT AND VENTS.
9. EXISTING DOOR TO REMAIN, PAINT/FINISH AS INDICATED ON ROOM FINISH SCHEDULE.

9a. EXISTING DOOR TO REMAIN.

10. ALUM STOREFRONT/WINDOW/GLAZED WALL/ENTRANCE, SEE DOOR SCHEDULE.
11. EXISTING WINDOW WALL/STOREFRONT TO REMAIN.
12. EXISTING WINDOW WALL/STOREFRONT TO REMAIN, REPLACE WINDOW AND PANELS WHERE INDICATED, CLEAN EXISTING ALUM FRAMES, INSTALL SEALANT AT THE JOINT BETWEEN WALL AND FRAME AND WHERE REQUIRED, FINISH PER DOOR AND WINDOW SCHEDULE.
13. PASS THRU WINDOW, SEE A–SERIES DWGS. FOR DETAILS.
14. 1 1/2" DIA. ANODIZED ALUM HANDRAIL AND GUARD RAIL, WITH VERTICAL SUPPORTS NOT EXCEEDING 4'–0" O.C. PATCH/ REPAIR WALLS AND CONC CURB/FLOOR AS REQUIRED AFTER INSTALLING ANCHORS. SEE SPECIFICATIONS FOR MORE INFO.
15. EXTERIOR CONCRETE STEPS AND LANDING AT COURTYARD SHALL BE REPAIRED, CRACKS AND SPALLS PATCHED AND SURFACE CLEANED TO REMOVE DISCOLORATION. ALL JOINTS BETWEEN CONCRETE AND EXISTING BUILDING WALLS SHALL BE SEALED WITH ELASTOMERIC SEALANT, SEE SPECIFICATIONS. SEE S SERIES DWGS FOR CONC REPAIR DETAILS.
16. AT BRICK WALLS; CLEAN, REMOVE STAINS, REPOINT MISSING MORTAR JOINTS, REPAIR SPALLS, REMOVE AND REPLACE DAMAGED BRICKS, SEE SPECIFICATIONS.
17. SEE ROOM FINISH SCHEDULE FOR ALL FINISHES.
18. INSTALL CABINETS/ KITCHEN FURNITURE/ SHELVES/OTHER RELATED ITEMS; SEE DETAIL DRAWINGS.
19. INSTALL RELOCATED FURNITURE, CASEWORK AND EQUIPMENT.
20. PLATFORM LIFT, SEE A, S, E–SERIES DRAWINGS.
21. KITCHEN HOOD AND FIRE SAFETY SYSTEM, SEE A, P, E, H–SERIES DWGS.
22. VERTICAL CHASE FOR SUPPLY/EXHAUST HOOD, SEE H SERIES DWGS FOR SIZE, EXTEND THE CHASE WALLS THRU FIRST FLOOR CEILING, SECOND FLOOR AND TO THE ROOF.
AT SECOND FLOOR VERIFY THE LOCATION WITH EXISTING WALL, STRUCTURAL COMPONENTS AND OTHER EXISTING ITEMS, BEFORE CUTTING OPENING AND CONSTRUCTING THE CHASE WALLS. IF ANY DISCREPANCY OCCURS REACH OUT TO ARCHITECT/ENGINEER AND OWNER. ALL WORK RELATED TO THE CONSTRUCTION OF CHASE IS PART OF THIS WORK, NO ADDITIONAL PAYMENT WILL BE MADE, CONTRACTORS SHALL VERIFY EXISTING CONDITIONS DURING PRE–BID SITE VISIT.
23. MECHANICAL EQUIPMENT PAD, SEE H, S SERIES DWGS.
24. LANDSCAPE DETAILS, SEE C SERIES DWGS.

LEGEND:

ROOM NAME 100	ROOM NAME & NUMBER SEE DWG A20 FOR ROOM FINISH SCHEDULE
D01	DOOR NUMBER SEE DWG A–19 FOR DOOR SCHEDULE
W	WINDOW/STOREFRONT TYPE SEE DWG A16 FOR DETAILS
1	WALL TYPE, SEE DWG A–15
F.E.	FIRE EXTINGUISHER, U.L. RATING 4A–80B:C MOUNTED 4'–0" A.F.F.; SEE SPECS.
x --.00	FINISHED FLOOR ELEVATION
R.O.	ROUGH OPENING
	SLOPE
F.D.	FLOOR DRAIN: SEE P–SERIES DWGS. FOR SIZE
C.O.	CLEAN OUT; SEE P–SERIES DWGS. FOR SIZE
	ADA CLEARANCE REQUIREMENT
	INDICATE EXIST. WALLS/WINDOWS/DOORS
	INDICATE NEW CONSTRUCTION

0 4' 8' 16'

SCALE: 1/8" = 1'–0"

ISSUED FOR BID-9/25/26

APPROVED
William R. Long
PROFESSIONAL ENGINEER
NEW JERSEY LICENSE NO. 33012

APPROVED
Anita S. Aradhya
REGISTERED ARCHITECT
NEW JERSEY LICENSE NO. 18769

REVISIONS	DATE	BY
1 ADDENDUM#2	11/12/25	AA

Tri-State Architects, P.C. / Alaimo Group
WILLIAM R. LONG, P.E. LIC. 33012
ANITA S. ARADHYA, R.A. LIC. 18769
200 HIGH STREET MOUNT HOLLY, N.J.

DATE: AUG. 2026
DESIGNED BY: AA
DRAWN BY: AA
CHECKED BY:
DEPT. HEAD:

CLIENT: WILLINGBORO TOWNSHIP
PROJECT LOCATION: WILLINGBORO TWP. BURLINGTON COUNTY NEW JERSEY
PROJECT NO.: M-0410-0011-000
CONTRACT NO.: BID#8-2026

KENNEDY CENTER
RENOVATION TO THE SENIOR CENTER


FLOOR PLAN
SENIOR CENTER

SCALE: AS NOTED

SHEET
A3


FILE NO.:

Plotted: 11/11/2026 10:12 AM Last saved: 11/10/2026 2:12 PM File Names: M:\Projects\M0410001\000\Drawings\CLQ-A2-A3-FloorPlan.dwg

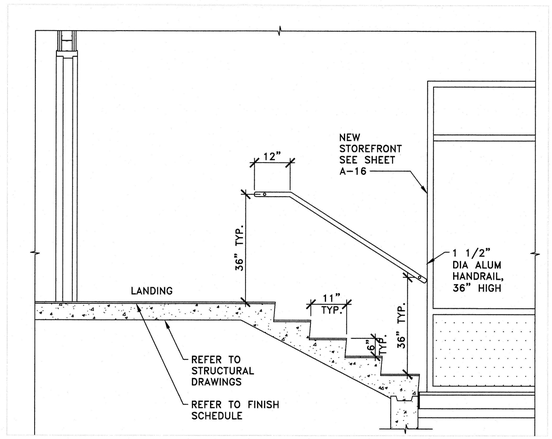

5 DETAILS- STAIR SECTION

NOT TO SCALE

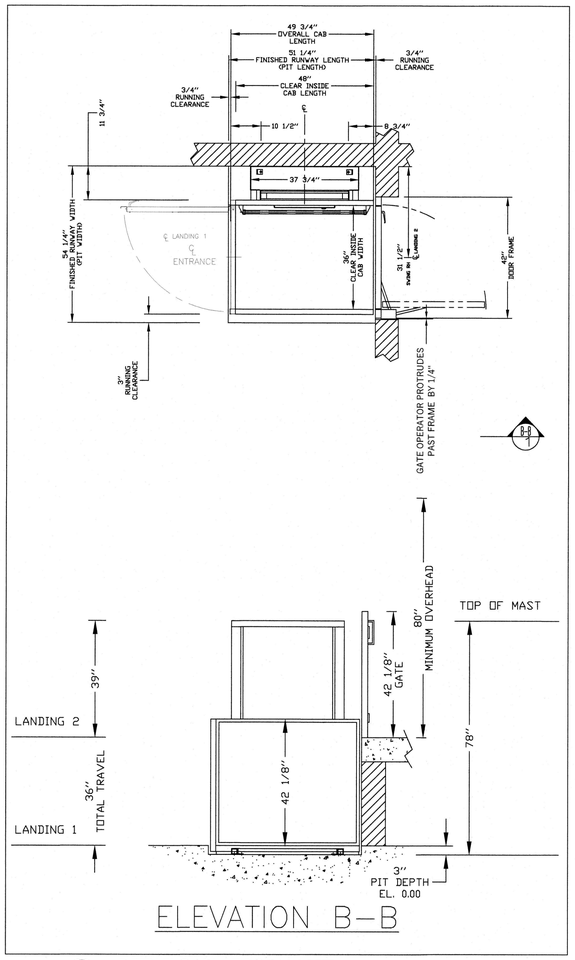

3 DETAILS- PLATFORM LIFT

NOT TO SCALE

PROVISIONS BY OTHERS

GENERAL

HOISTWAY –
THE HOISTWAY MUST BE DESIGNED AND BUILT IN ACCORDANCE WITH "SAFETY STANDARD FOR PLATFORM LIFTS AND STAIRWAY CHAIRLIFTS" OR "SAFETY CODE FOR ELEVATORS AND ESCALATORS" AND ALL STATE AND LOCAL CODES.

PLUMB RUNWAY:- DUE TO CLOSE RUNNING CLEARANCE OWNER/AGENT MUST ENSURE THAT HOISTWAY AND PIT (WHERE PROVIDED) ARE LEVEL, PLUMB (-/+ 1" (3mm)) AND SQUARE AND ARE IN ACCORDANCE WITH THE DIMENSIONS ON THESE DRAWINGS

MINIMUM OVERHEAD CLEARANCE:- OWNER/AGENT MUST ENSURE MINIMUM OVERHEAD CLEARANCE IS IN COMPLIANCE WITH CODES.

CONSTRUCTION SITE:- OWNER/AGENT TO PROVIDE ALL MASONARY, CARPENTRY AND DRYWALL WORK AS REQUIRED AND SHALL PATCH AND MAKE GOOD (INCLUDING FINISH PAINTING) ALL AREAS WHERE WALLS/FLOORS MAY REQUIRE TO BE CUT, DRILLED OR ALTERED IN ANY WAY TO PERMIT THE PROPER INSTALLATION OF THE LIFT.

DIMENSIONS:- CONTRACTOR/CUSTOMER TO VERIFY ALL DIMENSIONS AND REPORT ANY DISCREPANCIES TO OUR OFFICE IMMEDIATELY.

STRUCTURAL

FLOOR/SUPPORT WALL LOADS:- STRUCTURE TO ANCHOR A CRANK SHAFT AND SAFETY HARNESS, WHERE APPLICABLE/NEEDED, TO BE PROVIDED BY CONTRACTOR. CONTRACTOR TO ASSURE THAT BUILDING AND SHAFT WILL SAFELY SUPPORT ALL LOADS IMPOSED BY THE LIFT EQUIPMENT. REFER TO THE LOAD DIAGRAM ON THIS DRAWING.

MAST TO BE SECURELY FASTENED:-
WHERE REQUIRED THE MAST MUST BE SECURELY FASTENED TO THE STRUCTURAL SUPPORT FLOOR. REFER TO FLOOR SUPPORT LOAD DIAGRAM AND ANCHOR DIMENSIONS ON THIS DRAWING. NO WALL LOADS SINCE THIS UNIT CAN ONLY BE FREE STANDING.

WHERE DOORS ARE REQUIRED:- SUITABLE LINTELS MUST BE PROVIDED BY OWNER/AGENT. DOOR FRAMES ARE NOT DESIGNED TO SUPPORT OVERHEAD WALL LOADS.

ELECTRICAL

GENERAL:- ELECTRICAL EQUIPMENT AND WIRING TO COMPLY WITH SECTION 38 OF CSA C22.1 (CANADA) OR SECTION 620 OF NEC ANSI/NFPA 70 (USA).

POWER SUPPLY:- 120VAC, 20A, 60HZ, 1PH CIRCUIT THROUGH A FUSE DISCONNECT WITH AUXILIARY CONTACT ON MAIN POWER SUPPLY. PROVIDE TWO 18 AWG CONDUCTORS BETWEEN CONTACT AND CONTROLLER.

LIGHTING:- LIGHTING OF 100 LX MIN. AT PLATFORM AND LANDINGS. LIGHTING WITH SWITCH AND ELECTRICAL GFCI OUTLET IN HOISTWAY PIT.

SAVARIA LINK REMOTE MONITORING – NOT APPLICABLE
Not required

PHONE:-
IF A TELEPHONE CIRCUIT IS REQUIRED, JACK OR PHONE ARE PROVIDED ON THE CAR. A DEDICATED ANALOG PHONE LINE (NO VOIP) IS REQUIRED TO BE PROVIDED BY OTHERS TO THE CONTROLLER FOR VOIP, PLEASE CONTACT SAVARIA.

ENTRANCES


UPPER LANDING GATE:- WHERE REQUIRED, SMOOTH SOLID BARRIERS ARE TO BE SUPPLIED AND INSTALLED ON BOTH SIDES OF ENTRANCE AT UPPER LEVEL AND MUST BE A MINIMUM OF 42" (1067mm) HIGH. ENTRANCE ASSEMBLY MUST BE IN PLACE PRIOR TO THIS PROVISION.

FASCIA PANEL BELOW UPPER LEVEL ENTRANCE:- WHERE REQUIRED, FASCIA PANEL MUST BE FASTENED TO A SOLID WALL AND BE PERPENDICULAR TO THE FLOOR AND WALLS. HOISTWAY FASCIA IS NOT SELF-SUPPORTING FOR LONG, CONTINUOUS RUNS VOID OF ENTRANCES. ADEQUATE SUPPORT FOR THE FASCIA MUST BE PROVIDED.


ENTRANCE ASSEMBLIES:- ENTRANCE ASSEMBLIES MUST BE ADJUSTED TO ALIGN WITH PLATFORM AND INTERLOCK EQUIPMENT. OTHERS TO ALLOW AN ADEQUATE ROUGH OPENING.

RETURN WALLS:- RETURN WALLS AT ENTRANCES MUST BE BUILT-IN BY OTHERS AFTER ENTRANCE ASSEMBLIES ARE IN PLACE. ENTRANCE ASSEMBLY MUST BE SECURELY FASTENED TO WALLS.

FREE STANDING UNIT

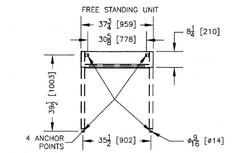

FLOOR SUPPORT LOAD DIAGRAM

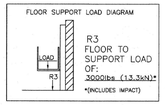

R3
FLOOR TO
SUPPORT LOAD
OF:
3000lbs (13.3kN)*
*(INCLUDES IMPACT)

DATA SHEET
VERTICAL WHEELCHAIR PLATFORM LIFT

OFFICE USE ONLY:
CONFIGURATION VERSION STAMP: 0.0
MODULE VERSION STAMP: 5.43

Part No.	MULTILIFT
Contract No.	1158497
TITLE: MOBILITY ELEVATOR & LIFT	DATE: 09-11-24
PROJECT: HAFTR	DRAWN BY: 09-11-24
ADDRESS: No. Street, City	CHECKED BY:
	JOB No. P-0000001
savaria.	SHEET No. 2 OF 3

SPECIFICATIONS

GENERAL

CLASSIFICATION:	Vertical Wheelchair Platform Lift
APPLIED CODE:	ASME A18.1–2017 Section 2 Pub
MODEL:	Multilift
CAPACITY:	750 lbs
SPEED:	8'/min (0.04 m/s)
TRAVEL:	36"
PIT DEPTH:	3"
PLATFORM SIZE:	36" X 48"
POWER SUPPLY:	110V,15A,60Hz,SINGLE PHASE
BATTERY BACK UP:	No
SUSPENSION:	ACME SCREW 25mm

SAFETIES:
BACK UP NUT AS PER ASME A18.1–2017 Section 2 Pub

POWER UNIT

MOTOR: 1.0 HP, 110/115 VAC

DOORS / GATES / CALL STATIONS

ENTRANCES

	LANDING 1	LANDING 2
DOOR TYPE	Platform Gate	42" – 1067mm Landing Gate
ENTRANCE SIDE	B	C
DOOR SWING		
DOOR INSERT	Steel Framed	Steel
LOCK TYPE	WR500 Lock	WR500 Lock
AUTO DOOR OPENER	Not Applicable	Gatekeeper
IN FRAME CALL STN.	no	yes
CALL STN. TYPE	Call/Send 2 Buttons	Call/Send 2 Buttons
CALL STN. KEYED	Not Required	Not Required
CALL STN. STOP BUTTON	no	no
CALL STN. MOUNTING	Surface Mounted Remote	Flush Mount
INSULATED PRODOOR KIT	No	No

ENTRANCE LOCATIONS



CONTROLLER


MODEL:	MULTILIFT
TYPE:	CPFS
OPS#:	LR1390-795
CONTROL VOLTS:	24VAC/12VDC
CONTROL AMPS:	1 A
AMPS:	15
MFR.:	SAVARIA

OPTIONS PROVIDED

TOUCH UP PAINT:	1 can(s)	RAMP:	No Ramp Required
BUILDING:	Public Building	EXTRA KEYS:	
UNDERPAN SENSOR:	yes	SAFETY PINS/BLOCKS:	no
EXTERIOR UNIT :	Yes	MANUAL LOWERING DEVICE:	yes
UNIT COLOUR:	Standard Colour – Beige	PIT SWITCH:	yes
FLOOR:	Anti-Skid Grey Paint	PHONE:	Hands free phone
FLOOR SWITCH:	no		
FOLD SEAT:	no		

OFFICE USE ONLY:
CONFIGURATION VERSION STAMP: 0.0
MODULE VERSION STAMP: 5.43

Part No.	MULTILIFT
Contract No.	1158497
TITLE: MOBILITY ELEVATOR & LIFT	DATE: 09-11-24
PROJECT: HAFTR	DRAWN BY: 09-11-24
ADDRESS: No. Street, City	CHECKED BY:
	JOB No. P-0000001
savaria.	SHEET No. 3 OF 3

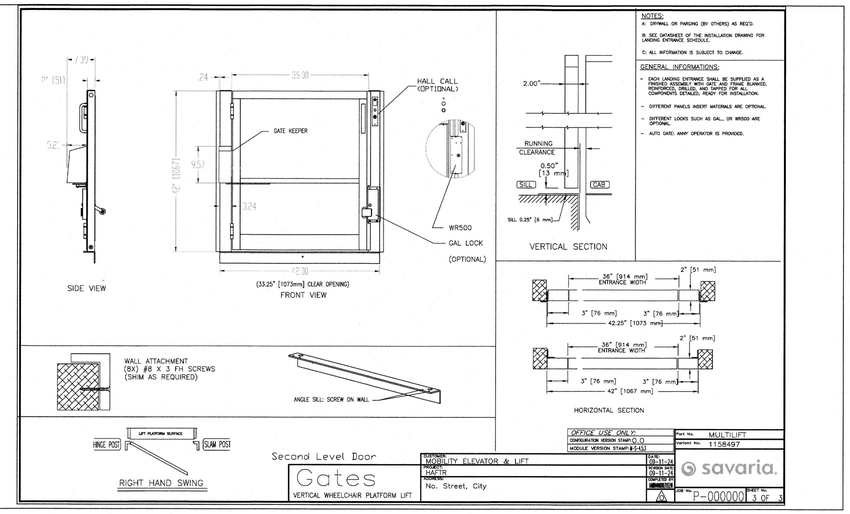


4 DETAILS- PLATFORM LIFT-SAVARIA OR EQUIVALENT

NOT TO SCALE

2 DETAILS- PLATFORM LIFT

SCALE : 1/2"=1'0"

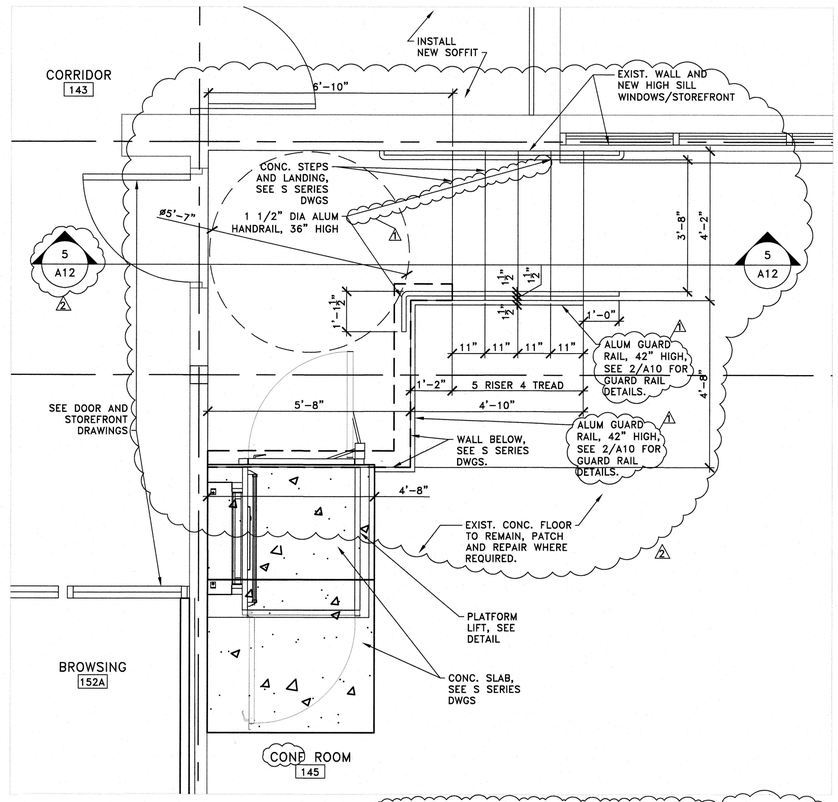

1 DETAILS- PLATFORM LIFT-(CONF RM- 145 AND COMPUTER RM-168 OPP.HAND)

SCALE : 1/2"=1'0"

ISSUED FOR BID-9/25/26

APPROVED
11.12.26
William R. Long
PROFESSIONAL ENGINEER
NEW JERSEY LICENSE NO. 33012

APPROVED
Anita S. Aradhya
REGISTERED ARCHITECT
NEW JERSEY LICENSE NO. 18769

BY	DATE	REVISIONS
AA	10/20/26	ADDENDUM#2
AA	11/12/26	ADDENDUM#3

Tri-State Architects, P.C. / Alaimo Group
WILLIAM R. LONG, P.E. LIC. 33012
ANITA S. ARADHYA, R.A. LIC. 18769
200 HIGH STREET MOUNT HOLLY, N.J.

DATE: AUG. 2026
DESIGNED BY: AA
DRAWN BY: AA
CHECKED BY:
DEPT. HEAD:

CLIENT: WILLINGBORO TOWNSHIP
PROJECT LOCATION: WILLINGBORO TWP. BURLINGTON COUNTY NEW JERSEY
PROJECT NO.: M-0410-0011-000
CONTRACT NO.: BID#8-2026

KENNEDY CENTER
RENOVATION TO THE SENIOR CENTER

PLATFORM LIFT DETAILS


SCALE: AS NOTED

SHEET
A12


FILE NO.:

Plotted: 11/11/2026 11:14 AM Last saved: 11/11/2026 11:13 AM File Name: M:\Projects\M0410001000\Drawings\GLO-A12-Platform Lift-Details.dwg


INTERIOR WINDOWS AND ENTRANCES

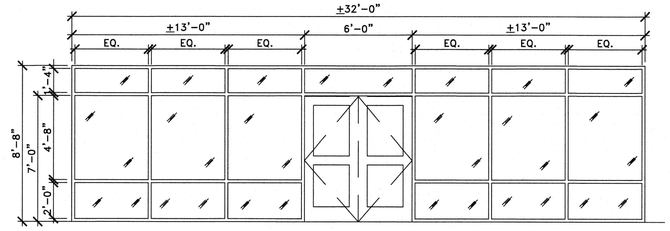

1A (152-B)
1B (152-A)

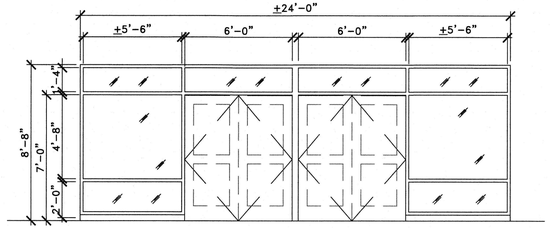

2A (169-1) (169-2)
2B (143-1) (143-2)

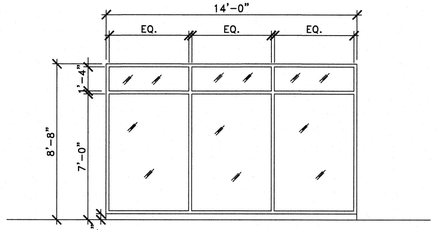


3

STOREFRONT AND ENTRANCE DOOR NOTES:


1. MEASURE MASONRY OPENINGS PRIOR TO ORDERING STOREFRONT AND DOORS.
2. COORDINATE WITH OWNER ON INSTALLATION OF TEMPORARY PARTITIONS DURING DEMOLITION AND INSTALLATION OF STOREFRONT AND DOORS.
3. CAREFULLY EXAMINE EXISTING CONDITION AT FLOOR, WALLS AND CEILING FOR ANCHOR AND FASTENING OF THE STOREFRONT FRAME. FASTENER AND ANCHORS SHALL BE PER STOREFRONT MANUFACTURER.
4. GC SHALL COORDINATE W/ OTHER TRADES DURING THE WORK AT THE MAIN ENTRANCE LOBBY.
5. PROVIDE APPROPRIATE STRUCTURAL STEEL; SIZE AND ATTACHMENT AT STOREFRONT PER MANUFACTURER'S RECOMMENDATIONS.
6. REFER TO STRUCTURAL DRAWING S1 FOR WIND SPEED AND OTHER DESIGN REQUIREMENTS.
7. CONTRACTOR SHALL PROVIDE 3 SAMPLES FOR COLOR SELECTION BY ARCHITECT AND OWNER.
8. THE ENTRANCE DOORS SHALL BE ADA COMPLIANT, PER NJ IBC 2021 NJ EDITION, LOCAL, STATE AND ALL APPLICABLE CODES.

KEY NOTES:

1. ALUM. DOOR, SEE DOOR SCHEDULE.
2. ALUM STOREFRONT SYSTEM SEE DRAWINGS A16, A17 A18, A19 & A20.
3. INSTALL NEW FIXED ALUM WINDOW IN EXISTING FRAME, MATCH ADJACENT.
4. INSTALL NEW WINDOW PANEL IN EXISTING FRAME, MATCH ADJACENT/EXISTING.
5. EXISTING TO REMAIN, PROTECT DURING CONSTRUCTION.
6. INSTALL NEW DOOR IN EXISTING FRAME, REPAIR OR INSTALL NEW FRAME IF REQUIRED.

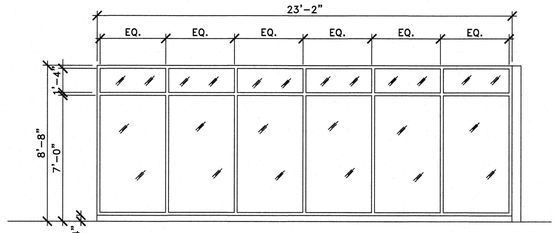


4A

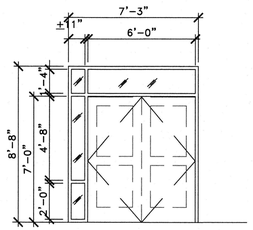


169-3

4A1

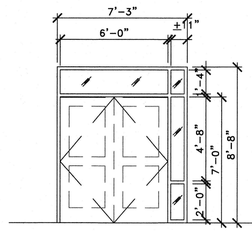


143-3

4B1

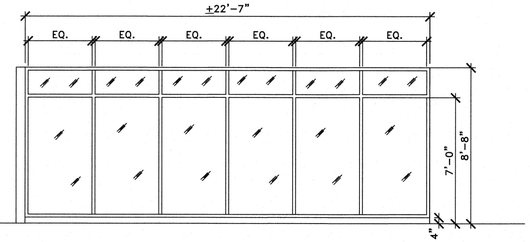


4B

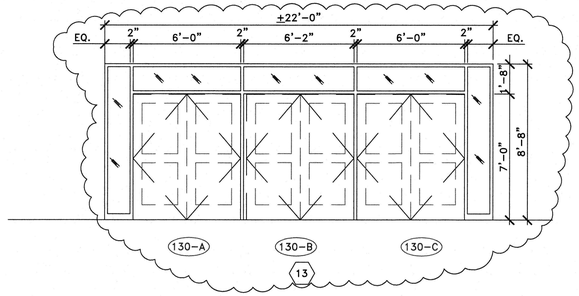


130-A 130-B 130-C

13

EXTERIOR WINDOWS AND ENTRANCES

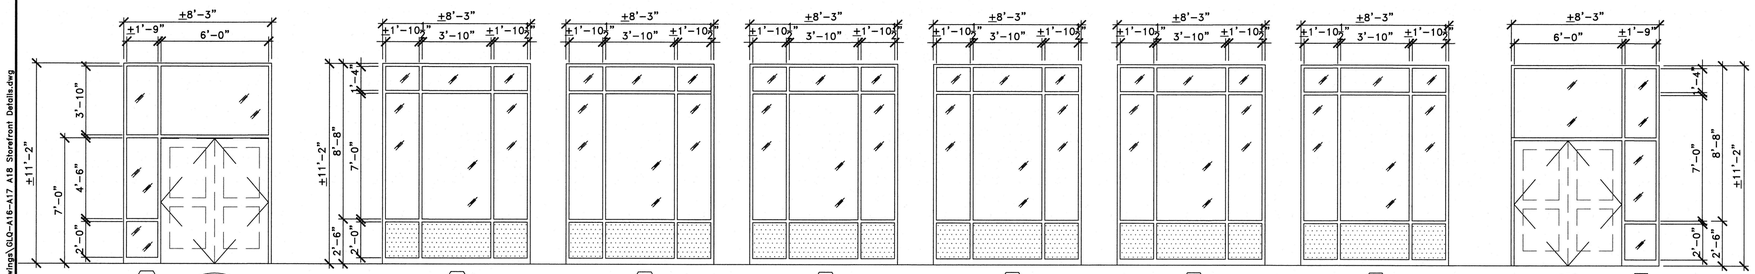


5A (153-1) 6A 6B 6C 6D 6E 6F (153-2) 5B

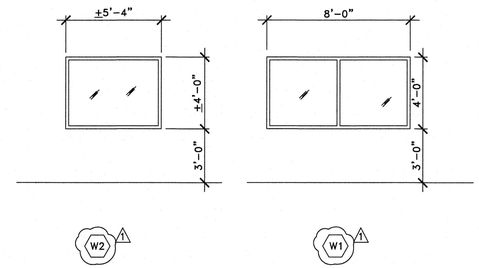

W2 W1


ENTRANCE 2

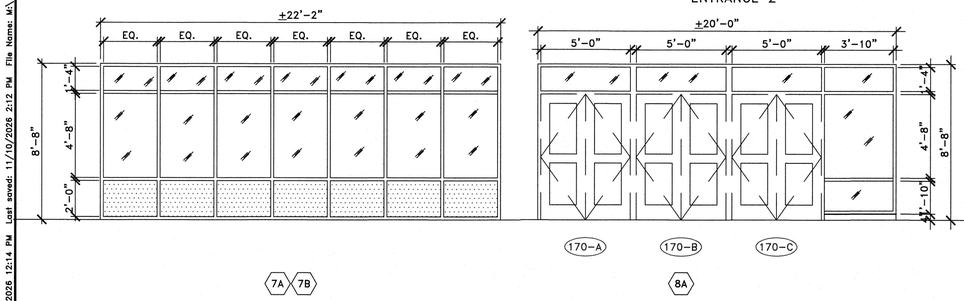


7A 7B

170-A 170-B 170-C

8A

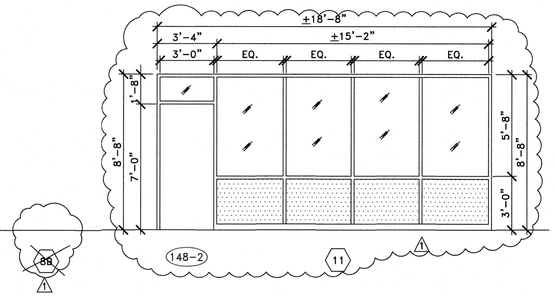


148-2 11

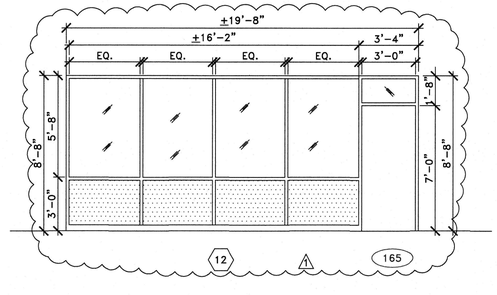

12 165

SLIDING FOOD SERVICE WINDOW: HEAVY DUTY ALUMINUM FRAME, 5/8" INSULATED GLASS, COLOR-DARK BRONZE. SELF-CLOSING W/ TOP-HUNG BALL BEARING SYSTEM AND SECURITY LOCK. MANUFACTURER: QUIKSERV OR EQUIVALENT

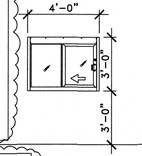

REFER TO DETAIL PLANS AND SECTIONS-17/A18

W3

1 STOREFRONT DETAILS

SCALE : 1/4"=1'0"

ISSUED FOR BID-9/25/26

Plotted: 11/11/2025 12:14 PM Last saved: 11/10/2026 2:12 PM File Name: M:\Projects\M0410001\1000\Drawings\GLO-A16-A17 A18 Storefront Details.dwg

APPROVED
William R. Long
PROFESSIONAL ENGINEER
NEW JERSEY LICENSE NO. 33012

APPROVED
Anita S. Aradhya
REGISTERED ARCHITECT
NEW JERSEY LICENSE NO. 18769

REVISIONS	DATE	BY
1 ADDENDUMS	11/12/26	AA

Tri-State Architects, P.C. / Alaimo Group
WILLIAM R. LONG, P.E. LIC. 33012
ANITA S. ARADHYA, R.A. LIC. 18769
200 HIGH STREET MOUNT HOLLY, N.J.

DATE: AUG. 2026
DESIGNED BY: AA
DRAWN BY:
CHECKED BY:
DEPT. HEAD:

CLIENT: WILLINGBORO TOWNSHIP
PROJECT LOCATION: WILLINGBORO TWP. BURLINGTON COUNTY NEW JERSEY
PROJECT NO.: M-0410-0011-000
CONTRACT NO.: BID#8-2026

KENNEDY CENTER
RENOVATION TO THE SENIOR CENTER


STOREFRONT DETAILS

SCALE: AS NOTED


SHEET
A16

FILE NO.:


STOREFRONT AND ENTRANCE DOOR NOTES:
1 MEASURE MASONRY OPENINGS PRIOR TO ORDERING STOREFRONT AND DOORS.
2 COORDINATE WITH OWNER ON INSTALLATION OF TEMPORARY PARTITIONS DURING DEMOLITION AND INSTALLATION OF STOREFRONT AND DOORS.
3 CAREFULLY EXAMINE EXISTING CONDITION AT FLOOR, WALLS AND CEILING FOR ANCHOR AND FASTENING OF THE STOREFRONT FRAME. FASTENER AND ANCHORS SHALL BE PER STOREFRONT MANUFACTURER.
4 GC SHALL COORDINATE W/ OTHER TRADES DURING THE WORK AT THE MAIN ENTRANCE LOBBY.
5 PROVIDE APPROPRIATE STRUCTURAL STEEL; SIZE AND ATTACHMENT AT STOREFRONT PER MANUFACTURER'S RECOMMENDATIONS.
6 REFER TO STRUCTURAL DRAWING S1 FOR WIND SPEED AND OTHER DESIGN REQUIREMENTS.
7 CONTRACTOR SHALL PROVIDE 3 SAMPLES FOR COLOR SELECTION BY ARCHITECT AND OWNER.
8 THE ENTRANCE DOORS SHALL BE ADA COMPLIANT, PER NJ IBC 2021 NJ EDITION, LOCAL, STATE AND ALL APPLICABLE CODES.
KEY NOTES:
1. ALUM. DOOR, SEE DOOR SCHEDULE.
2. ALUM STOREFRONT SYSTEM SEE DRAWINGS A16, A17 A18, A19 & A20.
3. INSTALL NEW FIXED ALUM WINDOW IN EXISTING FRAME, MATCH ADJACENT.
4. INSTALL NEW WINDOW PANEL IN EXISTING FRAME, MATCH ADJACENT/EXISTING.
5. EXISTING TO REMAIN, PROTECT DURING CONSTRUCTION.
6. INSTALL NEW DOOR IN EXISTING FRAME, REPAIR OR INSTALL NEW FRAME IF REQUIRED.

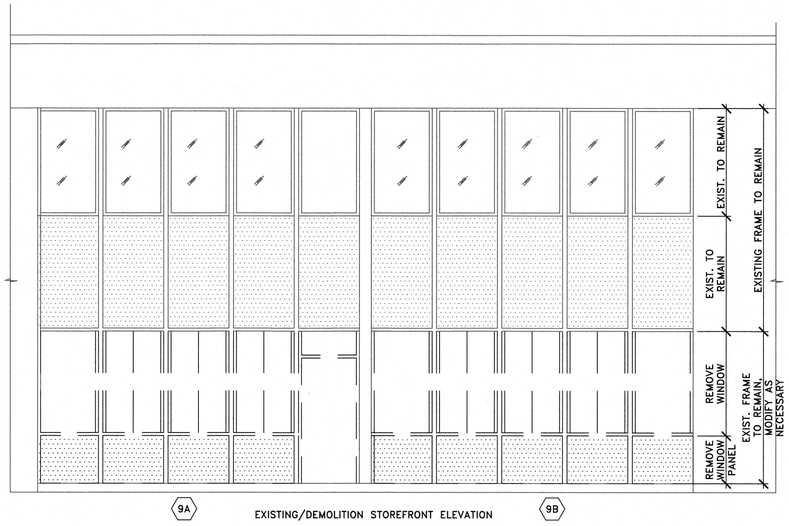


EXISTING/DEMOLITION STOREFRONT ELEVATION

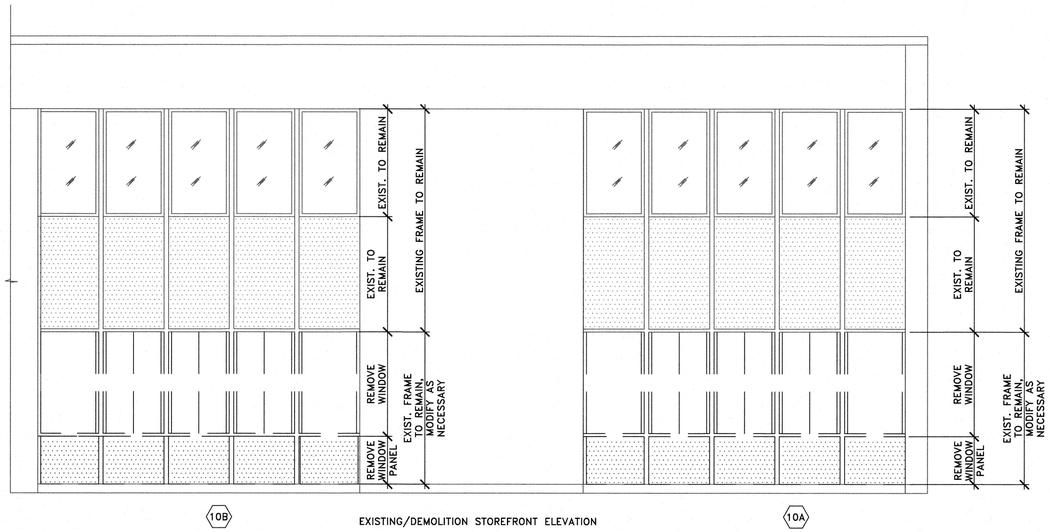

EXISTING/DEMOLITION STOREFRONT ELEVATION

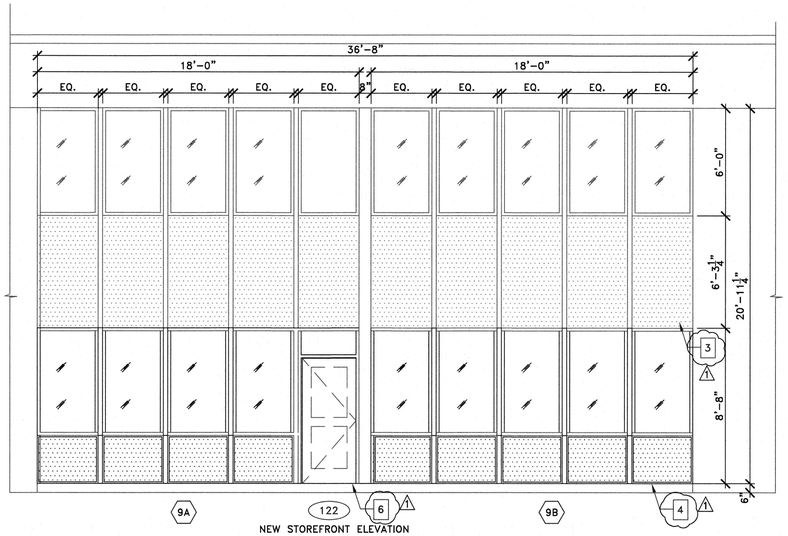

NEW STOREFRONT ELEVATION

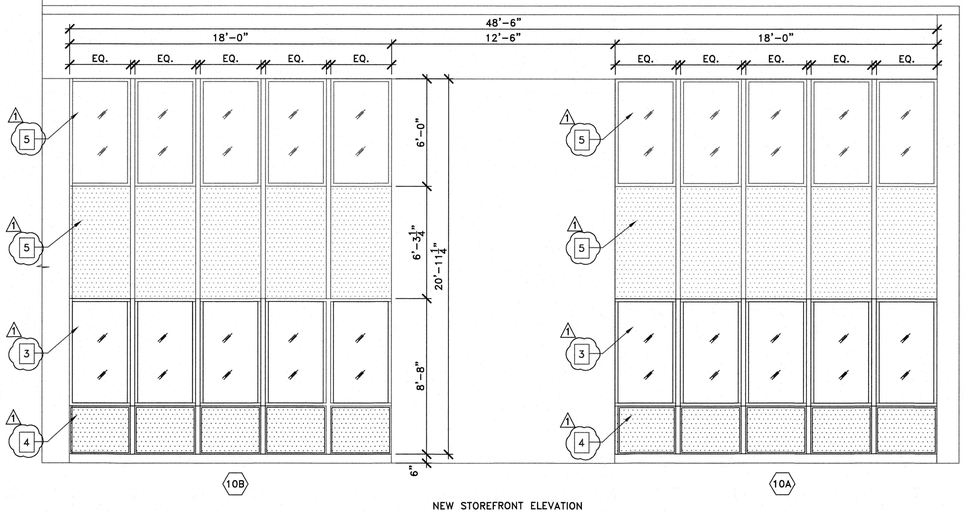

NEW STOREFRONT ELEVATION

1 STOREFRONT ELEVATIONS

SCALE : 1/4"=1'0"

ISSUED FOR BID-9/25/26

Plotted: 11/11/2026 11:27 AM Last saved: 11/10/2026 2:12 PM File Name: M:\Projects\M04100011900\Drawings\Gi,G-A16-A17 A18 Storefront Details.dwg

APPROVED

William R. Long
PROFESSIONAL ENGINEER
NEW JERSEY LICENSE NO. 33012

APPROVED

Anita S. Aradhya
REGISTERED ARCHITECT
NEW JERSEY LICENSE NO. 18769

REVISIONS	DATE	BY
1 ADDENDUM#5	11/12/26	AA

Tri-State Architects, P.C. / Alaimo Group

WILLIAM R. LONG, P.E. LIC. 33012
ANITA S. ARADHYA, R.A. LIC. 18769
200 HIGH STREET MOUNT HOLLY, N.J.

DATE: AUG. 2026
DESIGNED BY: AA
DRAWN BY: AA
CHECKED BY:
DEPT. HEAD:

CLIENT: WILLINGBORO TOWNSHIP

KENNEDY CENTER
RENOVATION TO THE SENIOR CENTER

PROJECT LOCATION: WILLINGBORO TWP. BURLINGTON COUNTY NEW JERSEY


PROJECT NO.: M-04100011900
CONTRACT NO.: BID#8-2026

STOREFRONT DETAILS


SCALE: AS NOTED

SHEET
A17


FILE NO.:

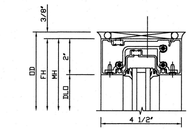


16 SECTION-DOOR
NOT TO SCALE

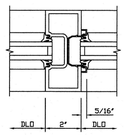


15 DETAIL-DOOR
NOT TO SCALE

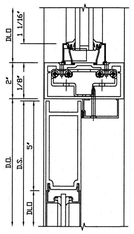

14 SECTION-DOOR
NOT TO SCALE

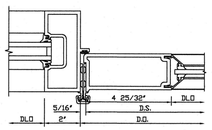


13 DETAIL-DOOR
NOT TO SCALE

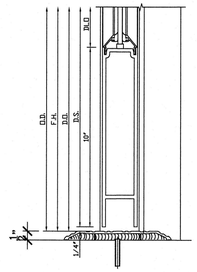



KAWNEER 500 HEAVY WALL ENTRANCES
TRIFAB 451 FRAMING – 1" GLAZING OR EQUAL
HEAVY DETAILS, CONT HINGE, CONCEALED CLOSER

12 SECTION-DOOR
NOT TO SCALE

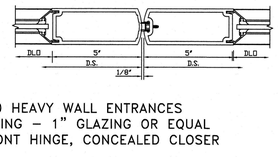


11 DETAIL-DOOR
NOT TO SCALE

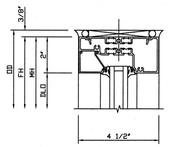

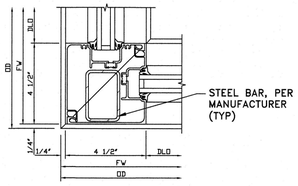


STEEL BAR, PER MANUFACTURER (TYP)

10 SECTION- STOREFRONT
NOT TO SCALE

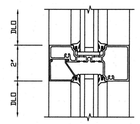


9 DETAIL-OUTSIDE CORNER
NOT TO SCALE

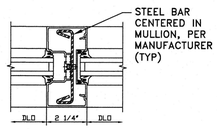


STEEL BAR CENTERED IN MULLION, PER MANUFACTURER (TYP)

8 SECTION- STOREFRONT
NOT TO SCALE

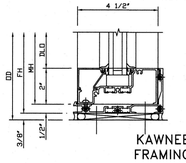

7 DETAIL-MULLION
NOT TO SCALE

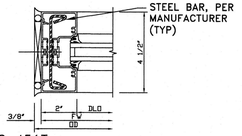


STEEL BAR, PER MANUFACTURER (TYP)

KAWNEER TRIFAB™ VG 451T
FRAMING SYSTEM OR EQUAL
CENTER SET W/1" GLAZING INFILL

6 SECTION- STOREFRONT
NOT TO SCALE

5 DETAIL-JAMB
NOT TO SCALE

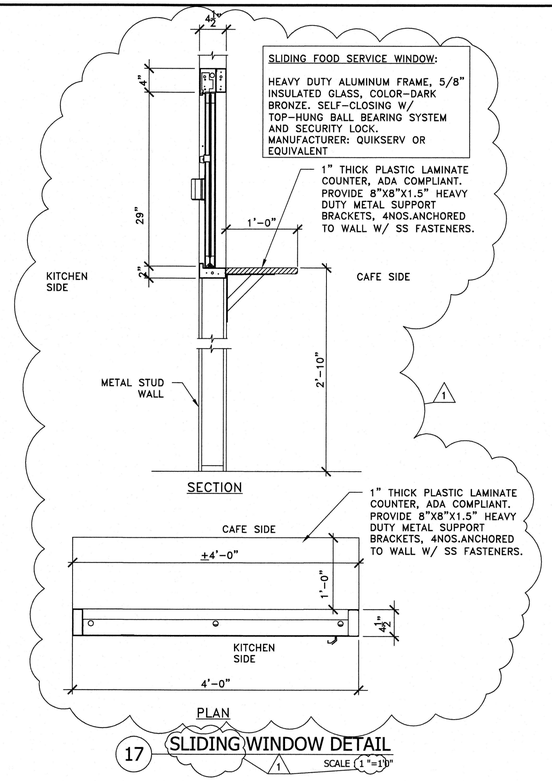


SLIDING FOOD SERVICE WINDOW:

HEAVY DUTY ALUMINUM FRAME, 5/8" INSULATED GLASS, COLOR–DARK BRONZE. SELF–CLOSING W/ TOP–HUNG BALL BEARING SYSTEM AND SECURITY LOCK. MANUFACTURER: QUIKSERV OR EQUIVALENT


1" THICK PLASTIC LAMINATE COUNTER, ADA COMPLIANT. PROVIDE 8"X8"X1.5" HEAVY DUTY METAL SUPPORT BRACKETS, 4NOS.ANCHORED TO WALL W/ SS FASTENERS.

1" THICK PLASTIC LAMINATE COUNTER, ADA COMPLIANT. PROVIDE 8"X8"X1.5" HEAVY DUTY METAL SUPPORT BRACKETS, 4NOS.ANCHORED TO WALL W/ SS FASTENERS.

17 SLIDING WINDOW DETAIL
SCALE 1"=1'0"

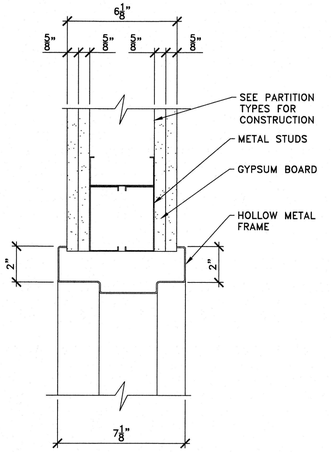

4 HEAD DETAIL
SCALE :3"=1'0"

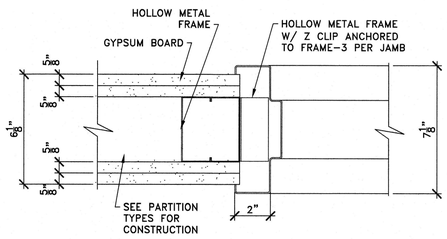


3 JAMB DETAIL
SCALE :3"=1'0"

STOREFRONT AND ENTRANCE DOOR NOTES:


1. MEASURE MASONRY OPENINGS PRIOR TO ORDERING STOREFRONT AND DOORS.
2. COORDINATE WITH OWNER ON INSTALLATION OF TEMPORARY PARTITIONS DURING DEMOLITION AND INSTALLATION OF STOREFRONT AND DOORS.
3. CAREFULLY EXAMINE EXISTING CONDITION AT FLOOR, WALLS AND CEILING FOR ANCHOR AND FASTENING OF THE STOREFRONT FRAME. FASTENER AND ANCHORS SHALL BE PER STOREFRONT MANUFACTURER.
4. GC SHALL COORDINATE W/ OTHER TRADES DURING THE WORK AT THE MAIN ENTRANCE LOBBY.
5. PROVIDE APPROPRIATE STRUCTURAL STEEL; SIZE AND ATTACHMENT AT STOREFRONT PER MANUFACTURER'S RECOMMENDATIONS.
6. REFER TO STRUCTURAL DRAWING S1 FOR WIND SPEED AND OTHER DESIGN REQUIREMENTS.
7. CONTRACTOR SHALL PROVIDE 3 SAMPLES FOR COLOR SELECTION BY ARCHITECT AND OWNER.
8. THE ENTRANCE DOORS SHALL BE ADA COMPLIANT, PER NJ IBC 2021 NJ EDITION, LOCAL, STATE AND ALL APPLICABLE CODES.

KEY NOTES:


1. ALUM. DOOR, SEE DOOR SCHEDULE.
2. ALUM STOREFRONT SYSTEM SEE DRAWINGS A16, A17 A18, A19 & A20.
3. INSTALL NEW FIXED ALUM WINDOW IN EXISTING FRAME, MATCH ADJACENT.
4. INSTALL NEW WINDOW PANEL IN EXISTING FRAME, MATCH ADJACENT/EXISTING.
5. EXISTING TO REMAIN, PROTECT DURING CONSTRUCTION.
6. INSTALL NEW DOOR IN EXISTING FRAME, REPAIR OR INSTALL NEW FRAME IF REQUIRED.

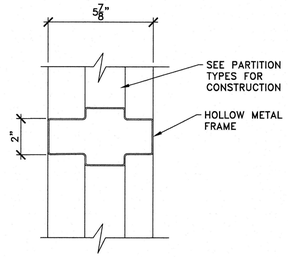

2A TRANSOM FRAME DETAIL
SCALE :3"=1'0"

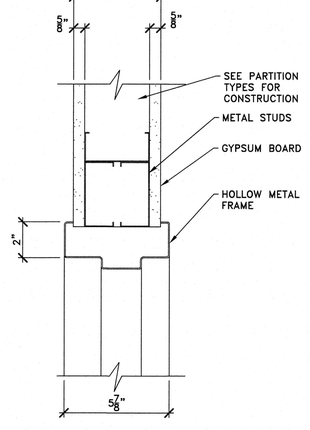

2 HEAD DETAIL
SCALE :3"=1'0"

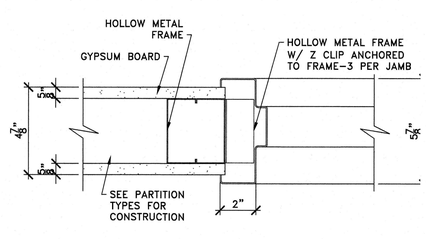

1 JAMB DETAIL
SCALE :3"=1'0"

ISSUED FOR BID-9/25/26

11.12.25
APPROVED
William R. Long
PROFESSIONAL ENGINEER
NEW JERSEY LICENSE NO. 33012

APPROVED
Anita S. Aradhya
REGISTERED ARCHITECT
NEW JERSEY LICENSE NO. 18769

REVISIONS	DATE	BY
1 ADDENDUM5	11/12/25	AA

Tri-State Architects, P.C. / Alaimo Group
WILLIAM R. LONG, P.E. LIC. 33012
ANITA S. ARADHYA, R.A. LIC. 18769
200 HIGH STREET MOUNT HOLLY, N.J.

DATE: AUG. 2026
DESIGNED BY: AA
DRAWN BY: AA
CHECKED BY:
DEPT. HEAD:

CLIENT: WILLINGBORO TOWNSHIP
PROJECT LOCATION: WILLINGBORO TWP. BURLINGTON COUNTY NEW JERSEY
PROJECT NO.: M-0410-0011-000
CONTRACT NO.: BID#8-2026

KENNEDY CENTER
RENOVATION TO THE SENIOR CENTER
STOREFRONT AND WINDOW DETAILS
SCALE: AS NOTED

SHEET
A18

FILE NO.:

Plotted: 11/11/2026 11:26 AM Last saved: 11/10/2026 2:12 PM File Name: M:\Projects\M0410001\000\Drawings\GLO-A16-A17 A18 Storefront Details.dwg

WINDOWS & LOUVER SCHEDULE

WINDOWS						
WINDOW	QTY.	WIDTH	HEIGHT	TYPE	MATERIAL	REMARKS
W1	2	8'-0"	4'0"	FIXED	ALUM	SEE DWG. A16
W2	4	±5'-4"	±4'-0"	FIXED	ALUM	SEE DWG. A16
W3	1	4'-0"	3'-0"	PASS-THRU SLIDING WINDOW	ALUM	SEE DWG. A16
~~7A~~						1
~~7B~~ 1						
LOUVER						
L1	1	SEE H SERIES DWGS		STOREFRONT (EXIST)	AL	NOTE 1

LEGEND:
ALUM- HEAVY GAUGE EXTRUDED 6063-T5 ALUMINUM W/ 70% KYNAR PVDF FINISH.

NOTES:

1. SEE H-SERIES DWGS FOR MAKEUP AIR/EXHAUST LOUVERS. ALL SHALL BE ALUM, WITH 70% KYNAR/PVDF FINISH, COLOR TO BE SELECTED BY ARCHITECT AND APPROVED BY OWNER.
2. ALL WINDOWS SHALL HAVE END DAMS AND SILL FLASHING WITH TYPE 304 STAINLESS STEEL, SEE DETAIL 3/A16. SEPARATE DIFFERENT METALS WHEN IN CONTACT WITH APPROPRIATE MATERIAL.
3. GLAZING SHALL BE INSULATED, FIRE PROTECTION RATED GLASS. FIRE PROTECTION TO MATCH WINDOWS/ DOORS THEY ARE LOCATED AT.
4. SEE SPECIFICATIONS FOR MORE INFORMATION.
5. SEE H DRAWINGS FOR WALL LOUVER FOR EQUIPMENT/DUCTS. LOUVER SHALL BE KYNAR FINISHED IN STANDARD COLORS.
6. ALL COLOR SHALL BE SELECTED BY ARCHITECT AND APPROVED BY OWNER.

STOREFRONT SYSTEMS SCHEDULE

STOREFRONT	QTY.	WIDTH	HEIGHT	TYPE	DOOR	MATERIAL	FINISH 1	REMARKS
1A	1	32'-0"	8'-8"	STOREFRONT	YES	AL	ANODIZED	SEE DWG A16
1B	1	32'-0"	8'-8"	STOREFRONT	YES	AL	ANODIZED	SEE DWG A16
2A	1	24'-0"	8'-8"	STOREFRONT	YES	AL	ANODIZED	SEE DWG A16
2B	1	24'-0"	8'-8"	STOREFRONT	YES	AL	ANODIZED	SEE DWG A16
3	1	14'-0"	8'-8"	STOREFRONT	NO	AL	ANODIZED	SEE DWG A16
4A	1	23'-2"	8'-8"	STOREFRONT	NO	AL	ANODIZED	SEE DWG A16
4A1	1	7'-3"	8'-8"	STOREFRONT	YES	AL	ANODIZED	SEE DWG A16
4B	1	22'-7"	8'-8"	STOREFRONT	NO	AL	ANODIZED	SEE DWG A16
4B1	1	7'-3"	8'-8"	STOREFRONT	YES	AL	ANODIZED	SEE DWG A16
5A	1	8'-3"	11'-2"	STOREFRONT	YES	AL	ANODIZED	SEE DWG A16
5B	1	8'-3"	11'-2"	STOREFRONT	YES	AL	ANODIZED	SEE DWG A16
6A	1	8'-3"	11'-2"	STOREFRONT	NO	AL	ANODIZED	SEE DWG A16
6B	1	8'-3"	11'-2"	STOREFRONT	NO	AL	ANODIZED	SEE DWG A16
6C	1	8'-3"	11'-2"	STOREFRONT	NO	AL	ANODIZED	SEE DWG A16
6D	1	8'-3"	11'-2"	STOREFRONT	NO	AL	ANODIZED	SEE DWG A16
6E	1	8'-3"	11'-2"	STOREFRONT	NO	AL	ANODIZED	SEE DWG A16
6F	1	8'-3"	11'-2"	STOREFRONT	NO	AL	ANODIZED	SEE DWG A16
7A	1	22'-2"	8'-8"	STOREFRONT	NO	AL	ANODIZED	SEE DWG A16
7B	1	22'-2"	8'-8"	STOREFRONT	NO	AL	ANODIZED	SEE DWG A16
8A	1	20'-0"	8'-8"	STOREFRONT	YES	AL	ANODIZED	SEE DWG A16
~~8B~~								1
9A	1	18'-0"	20'-11 1/4"	STOREFRONT	YES	AL	ANODIZED	SEE DWG A17
9B	1	18'-0"	20'-11 1/4"	STOREFRONT	NO	AL	ANODIZED	SEE DWG A17
10A	1	18'-0"	20'-11 1/4"	STOREFRONT	NO	AL	ANODIZED	SEE DWG A17
10B	1	18'-0"	20'-11 1/4"	STOREFRONT	NO	AL	ANODIZED	SEE DWG A17
1 11	1	±18'-8"	8'-8"	STOREFRONT	YES	AL	ANODIZED	SEE DWG A16
12	1	±19'-8"	8'-8"	STOREFRONT	YES	AL	ANODIZED	SEE DWG A16

DOOR SCHEDULE

ROOM NAME	DOOR NUMBER	ROUGH OPENING	DOOR							FRAME						DETAILS			FIRE PROTECTION RATING-DOOR (HR)	HARDW ARE SET	ACCESS CONTROL		REMARKS
			WIDTH	HEIGHT	THICK.	TYPE	MATERIAL	FINISH	GLASS	WIDTH	HEIGHT	THICK.	TYPE	MATERIAL	FINISH	HEAD	JAMB	SILL					
KITCHEN	121-1	EXIST	3'-0"	6'-10"	1 3/4"	B	HM	PAINT	NO	EXIST	EXIST	EXIST	EXIST	HM	PAINT	-	-	-	-	-	-	-	NOTE 9
CLOSET	121-2	-	2(2'-6")	7'-0"	1 3/4"	I	HM	PAINT	NO	6'-4"	7'-2"	2"	7	HM	PAINT	-	-	-	-	-	-	-	-
KITCHEN	121-3	-	3'-0"	7'-0"	1 3/4"	B	HM	PAINT	NO	3'-4"	7'-2"	2"	5	HM	PAINT	-	-	-	-	-	-	-	-
CAFE	122	EXIST STOREFRONT	3'-0"	6'-10"	1 3/4"	G	AL	ANODIZED	YES	EXIST	EXIST	EXIST	EXIST	AL	EXIST	-	-	-	-	-	-	-	NOTE 9
KILN	126-A	-	2(3'-0")	7'-0"	1 3/4"	I	HM	PAINT	NO	6'-4"	7'-2"	2"	6	HM	PAINT	-	-	-	3/4	-	-	-	-
CRAFT GENERAL STORAGE	126-B	-	3'-0"	7'-0"	1 3/4"	B	WD	WD	NO	3'-4"	7'-2"	2"	5	HM	PAINT	-	-	-	-	-	-	-	-
STAIR HALL	130-A	STOREFRONT	2(3'-0")	7'-0"	1 3/4"	H	AL	ANODIZED	NO	6'-4"	7'-2"	2"	6	AL	ANODIZED	-	-	-	-	-	-	-	NOTE 10
	130-B	STOREFRONT	2(3'-0")	7'-0"	1 3/4"	H	AL	ANODIZED	NO	6'-4"	7'-2"	2"	6	AL	ANODIZED	-	-	-	-	-	-	-	NOTE 10
	130-C	STOREFRONT	2(3'-0")	7'-0"	1 3/4"	H	AL	ANODIZED	NO	6'-4"	7'-2"	2"	6	AL	ANODIZED	-	-	-	-	-	-	-	NOTE 10
CORRIDOR	143-1	STOREFRONT	2(3'-0")	6'-10"	1 3/4"	H	AL	ANODIZED	YES	6'-4"	7'-0"	ANOD	ANOD	AL	ANODIZED	-	-	-	-	-	-	-	-
	143-2	STOREFRONT	2(3'-0")	6'-10"	1 3/4"	H	AL	ANODIZED	YES	6'-4"	7'-0"	ANOD	ANOD	AL	ANODIZED	-	-	-	-	-	-	-	-
	143-3	STOREFRONT	2(3'-0")	6'-10"	1 3/4"	H	AL	ANODIZED	YES	6'-4"	7'-0"	ANOD	ANOD	AL	ANODIZED	-	-	-	-	-	-	-	NOTE 10
WOMEN'S ROOM	144	EXIST	3'-0"	6'-10"	1 3/4"	B	WD	WD	NO	EXIST	EXIST	EXIST	EXIST	HM	PAINT	-	-	-	-	-	-	-	NOTES 8,9
CONFERENCE ROOM	145-1	EXIST	3'-0"	6'-10"	1 3/4"	C	WD	WD	YES	EXIST	EXIST	EXIST	EXIST	HM	PAINT	-	-	-	-	-	-	-	NOTES 8,9
	145-2	EXIST	3'-0"	6'-10"	1 3/4"	C	WD	WD	YES	EXIST	EXIST	EXIST	EXIST	HM	PAINT	-	-	-	-	-	-	-	NOTES 8,9
UTILITY RM	148A	-	3'-0"	6'-10"	1 3/4"	B	HM	PAINT	NO	3'-4"	7'-0"	2"	5	HM	PAINT	-	-	-	-	-	-	-	-
SENSORY SPACE CHILDREN'S AREA	148-1	EXIST	3'-0"	6'-10"	1 3/4"	E	WD	WD	YES	EXIST	EXIST	EXIST	EXIST	HM	PAINT	-	-	-	-	-	-	-	NOTES 7,9
	148-2	EXIST	3'-0"	6'-10"	1 3/4"	E	WD	WD	YES	EXIST	EXIST	EXIST	5	HM	PAINT	-	-	-	-	-	-	-	-
CLOSET	150	EXIST	3'-0"	6'-10"	1 3/4"	A	WD	WD	NO	EXIST	EXIST	EXIST	EXIST	HM	PAINT	-	-	-	-	-	-	-	NOTES 7,9
TAPING	151-1	EXIST	3'-0"	6'-10"	1 3/4"	A	HM	PAINT	NO	EXIST	EXIST	EXIST	EXIST	HM	PAINT	-	-	-	3/4	-	-	-	NOTES 7,9
	151-2	-	3'-0"	6'-10"	1 3/4"	A	HM	PAINT	NO	3'-4"	7'-0"	2"	1	HM	PAINT	-	-	-	3/4	-	-	-	-
LOUNGE/STUDY AREA A	152-A	STOREFRONT	2(3'-0")	7'-0"	1 3/4"	H	AL	ANODIZED	YES	6'-4"	7'-2"	-	-	AL	ANODIZED	-	-	-	-	-	-	-	-
LOUNGE/STUDY AREA B	152-B	STOREFRONT	2(3'-0")	7'-0"	1 3/4"	H	AL	ANODIZED	YES	6'-4"	7'-2"	-	-	AL	ANODIZED	-	-	-	-	-	-	-	-
LOUNGE/STUDY AREA	153-1	STOREFRONT	2(3'-0")	7'-0"	1 3/4"	H	AL	ANODIZED	YES	6'-4"	7'-2"	-	-	AL	ANODIZED	-	-	-	-	-	-	-	-
	153-2	STOREFRONT	2(3'-0")	7'-0"	1 3/4"	H	AL	ANODIZED	YES	6'-4"	7'-2"	-	-	AL	ANODIZED	-	-	-	-	-	-	-	-
OFFICE	154	EXIST	3'-0"	6'-10"	1 3/4"	B	WD	WD	NO	EXIST	EXIST	EXIST	EXIST	HM	PAINT	-	-	-	-	-	-	-	NOTES 7,9
OFFICE	154A	EXIST	3'-0"	6'-10"	1 3/4"	B	WD	WD	NO	EXIST	EXIST	EXIST	EXIST	HM	PAINT	-	-	-	-	-	-	-	NOTES 7,9
WORK AREA	155-1	EXIST	3'-0"	6'-10"	1 3/4"	C	WD	WD	YES	EXIST	EXIST	EXIST	EXIST	HM	PAINT	-	-	-	-	-	-	-	NOTES 7,9
	155-2	EXIST	3'-0"	6'-10"	1 3/4"	B	WD	WD	NO	EXIST	EXIST	EXIST	EXIST	HM	PAINT	-	-	-	-	-	-	-	NOTES 7,9
PODCAST STUDIO	156-1	EXIST	3'-0"	6'-10"	1 3/4"	C	WD	WD	YES	EXIST	EXIST	EXIST	EXIST	HM	PAINT	-	-	-	-	-	-	-	NOTES 7,9
	156-2	EXIST	3'-0"	6'-10"	1 3/4"	C	WD	WD	YES	EXIST	EXIST	EXIST	EXIST	HM	PAINT	-	-	-	-	-	-	-	NOTES 7,9
OFFICE	162	EXIST	3'-0"	6'-10"	1 3/4"	A	WD	WD	NO	EXIST	EXIST	EXIST	EXIST	HM	PAINT	-	-	-	-	-	-	-	NOTES 7,9
OFFICE	163	EXIST	3'-0"	6'-10"	1 3/4"	A	WD	WD	NO	EXIST	EXIST	EXIST	EXIST	HM	PAINT	-	-	-	-	-	-	-	NOTES 7,9
OFFICE	164	EXIST	3'-0"	6'-10"	1 3/4"	B	WD	WD	NO	EXIST	EXIST	EXIST	EXIST	HM	PAINT	-	-	-	-	-	-	-	NOTES 8,9
OFFICE	165	STOREFRONT	3'-0"	6'-10"	1 3/4"	A	WD	WD	NO	3'-4"	7'-2"	-	-	AL	ANODIZED	-	-	-	-	-	-	-	-
BREAK ROOM	167	EXIST	3'-0"	6'-10"	1 3/4"	B	WD	WD	NO	EXIST	EXIST	EXIST	EXIST	HM	PAINT	-	-	-	-	-	-	-	NOTES 8,9
COMPUTER ROOM	168-1	EXIST	3'-0"	6'-10"	1 3/4"	C	WD	WD	YES	EXIST	EXIST	EXIST	EXIST	HM	PAINT	-	-	-	-	-	-	-	NOTES 8,9
	168-2	EXIST	3'-0"	6'-10"	1 3/4"	C	WD	WD	YES	EXIST	EXIST	EXIST	EXIST	HM	PAINT	-	-	-	-	-	-	-	NOTES 8,9
CORRIDOR	169-1	STOREFRONT	2(3'-0")	6'-10"	1 3/4"	H	AL	ANODIZED	YES	6'-4"	7'-0"	-	-	AL	ANODIZED	-	-	-	-	-	-	-	-
	169-2	STOREFRONT	2(3'-0")	6'-10"	1 3/4"	H	AL	ANODIZED	YES	6'-4"	7'-0"	-	-	AL	ANODIZED	-	-	-	-	-	-	-	-
	169-3	STOREFRONT	2(3'-0")	6'-10"	1 3/4"	H	AL	ANODIZED	YES	6'-4"	7'-0"	-	-	AL	ANODIZED	-	-	-	-	-	-	-	NOTE 10
ENTRANCE 2	170-A	STOREFRONT	2(3'-0")	6'-10"	1 3/4"	H	AL	ANODIZED	YES	6'-4"	7'-0"	-	-	AL	ANODIZED	-	-	-	-	-	-	-	NOTE 10
	170-B	STOREFRONT	2(3'-0")	6'-10"	1 3/4"	H	AL	ANODIZED	YES	6'-4"	7'-0"	-	-	AL	ANODIZED	-	-	-	-	-	-	-	NOTE 10
	170-C	STOREFRONT	2(3'-0")	6'-10"	1 3/4"	H	AL	ANODIZED	YES	6'-4"	7'-0"	-	-	AL	ANODIZED	-	-	-	-	-	-	-	NOTE 10

GALV.- HOT DIPPED GALVANIZED W/ KYNAR COAT FINISH- MANUFACTURER'S STANDARD COLORS
STEEL- STEEL PIPE/TUBE SECTION
PAINT - HEAVY DUTY PAINT FINISH, SEE SPEC FOR MORE INFORMATION.
PVDF - POLYVINYLIDENE FLUORIDE COATING OR KYNAR COATING
WD - WOOD LAMINATE FINISH- MATCH COLOR TO EXISTING OR PER OWNERS SELECTION
AL - EXTRUDED ALUMINUM - POWDER COATED FINISH, MATCH COLOR TO EXISTING OR PER OWNERS SELECTION
GL - GLASS - CLEAR, MATCH EXISTING OR PER OWNERS SELECTION
MNF - FINISHED BY MANUFACTURER
ANODIZED - ANODIZED FINISH, COLOR BY ARCHITECT, APPROVED BY OWNER. 1

NOTES:

1. SEE H-SERIES DWGS FOR 12X12 MAKEUP AIR/EXHAUST LOUVERS. ALL SHALL BE ALUM, WITH 70% KYNAR/PVDF FINISH, COLOR TO BE SELECTED BY ARCHITECT AND APPROVED BY OWNER.
2. ALL WINDOWS SHALL HAVE END DAMS AND SILL FLASHING WITH TYPE 304 STAINLESS STEEL. SEPARATE DIFFERENT METALS WHEN IN CONTACT WITH APPROPRIATE MATERIAL.
3. GLAZING SHALL BE INSULATED, FIRE PROTECTION RATED GLASS. FIRE PROTECTION TO MATCH WINDOWS/ DOORS THEY ARE LOCATED AT.
4. SEE SPECIFICATIONS FOR MORE INFORMATION.
5. SEE H DRAWINGS FOR WALL LOUVER FOR EQUIPMENT/DUCTS. LOUVER SHALL BE KYNAR FINISHED IN STANDARD COLORS.
6. ALL COLOR SHALL BE SELECTED BY ARCHITECT AND APPROVED BY OWNER.
7. EXISTING GLAZING AT SIDELITE AND TRANSOM TO REMAIN.
8. REPLACE TRANSOM PANEL W/ NEW PANEL.
9. VERIFY DOOR SIZES IN FIELD.
10. AT ALL EXTERIOR DOORS, STOREFRONTS, WINDOW WALLS, PROVIDE INSULATED PANEL, GLAZING AS NECESSARY.

ISSUED FOR BID-9/25/26

11.12.26
APPROVED
William R. Long
PROFESSIONAL ENGINEER
NEW JERSEY LICENSE NO. 33012

APPROVED
Anita S. Aradhya
REGISTERED ARCHITECT
NEW JERSEY LICENSE NO. 18769

REVISIONS		DATE	BY
1	ADDENDUM#3	11/12/26	AA

Tri-State Architects, P.C. / Alaimo Group

	LIC. 33012	WILLIAM R. LONG, P.E.
	LIC. 18769	ANITA S. ARADHYA, R.A.
	MOUNT HOLLY, N.J.	200 HIGH STREET

DATE: AUG. 2026
DESIGNED BY: AA
DRAWN BY: AA
CHECKED BY:
DEPT. HEAD:

CLIENT: WILLINGBORO TOWNSHIP
PROJECT LOCATION: WILLINGBORO TWP. BURLINGTON COUNTY NEW JERSEY
PROJECT NO.: M-0410-0011-000
CONTRACT NO.: BID#8-2026

KENNEDY CENTER
RENOVATION TO THE SENIOR CENTER

DOOR, WINDOW AND STOREFRONT SCHEDULE


SCALE: AS NOTED

SHEET
A19


FILE NO.:

Plotted: 11/11/2026 2:51 PM Last saved: 11/11/2026 2:51 PM File Name: M:\Projects\M0410001000\Drawings\GLO-A19-A20 Rm Fn & Door Schedule.dwg

DOOR TYPES

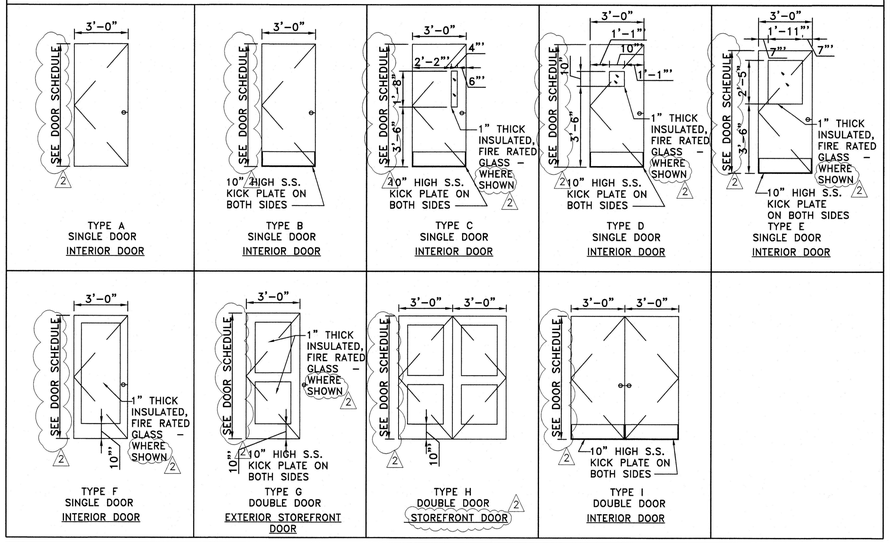

DOOR FRAME TYPES

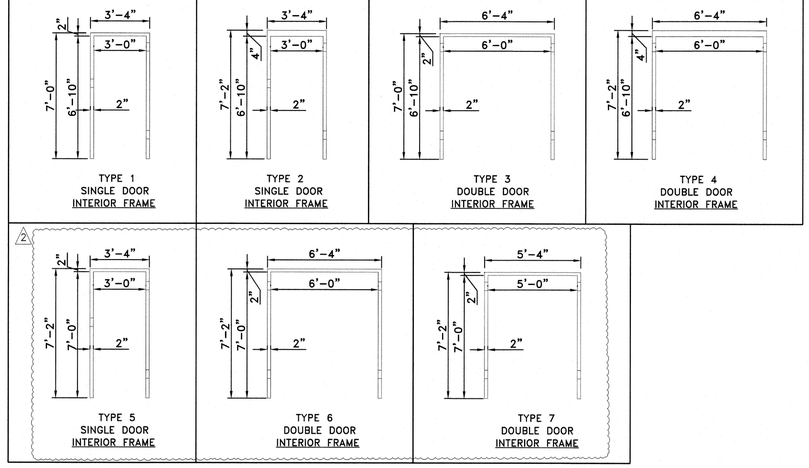

ROOM FINISH SCHEDULE

ROOM NAME	ROOM NUMBER	FLOOR	BASE	WALLS				CEILING		REMARKS
				NORTH	SOUTH	EAST	WEST	ACT	METAL	
KITCHEN	121	TILE-1	TILE-1	FRP	FRP	FRP	FRP	YES	NO	-
CLOSET	121-A	TILE-1	TILE-1	PAINT	PAINT	PAINT	PAINT	YES	NO	-
CAFE	122	LVT	VINYL	PAINT	PAINT	PAINT	PAINT	YES	NO	-
CRAFT ROOM	126	LVT	VINYL	PAINT	PAINT	PAINT	PAINT	YES	NO	-
KILN	126A	LVT	VINYL	PAINT	PAINT	PAINT	PAINT	YES	NO	-
CRAFT GENERAL STORAGE	126B	LVT	VINYL	PAINT	PAINT	PAINT	PAINT	YES	NO	-
STORAGE	126C	LVT	VINYL	PAINT	PAINT	PAINT	PAINT	YES	NO	-
ACTIVITY ROOM	127	LVT	VINYL	PAINT	PAINT	PAINT	PAINT	EXIST	NO	-
STAIRS HALL	130	LVT	VINYL	PAINT	PAINT	PAINT	PAINT	YES	NO	-
CORRIDOR	143	CARPET	VINYL	PAINT	PAINT	PAINT	PAINT	YES	NO	-
WOMEN'S ROOM	144	1 PORCELAIN	PORCELAIN	CERAMIC	CERAMIC	CERAMIC	CERAMIC	YES	NO	-
CONFERENCE ROOM	145	CARPET	VINYL	PAINT	PAINT	PAINT	PAINT	YES	NO	-
SENSORY SPACE CHILDREN'S AREA	148	CARPET	VINYL	PAINT	PAINT	PAINT	PAINT	YES	NO	-
UTILITY RM	148A	LVT	VINYL	PAINT	PAINT	PAINT	PAINT	YES	NO	-
CLOSET	150	LVT	VINYL	PAINT	PAINT	PAINT	PAINT	YES	NO	-
TAPING	151	LVT	VINYL	PAINT	PAINT	PAINT	PAINT	YES	NO	-
LOUNGE/STUDY AREA	152A	CARPET	VINYL	PAINT	PAINT	PAINT	PAINT	YES	NO	PRE-ENGINEERED WALL PANELS
LOUNGE/STUDY AREA	152B	CARPET	VINYL	PAINT	PAINT	PAINT	PAINT	YES	NO	PRE-ENGINEERED WALL PANELS
LOUNGE/STUDY AREA	153	CARPET	VINYL	PAINT	PAINT	PAINT	PAINT	YES	YES	PRE-ENGINEERED WALL PANELS
OFFICE	154	LVT	VINYL	PAINT	PAINT	PAINT	PAINT	YES	NO	-
OFFICE	154A	LVT	VINYL	PAINT	PAINT	PAINT	PAINT	YES	NO	-
WORK AREA	155	LVT	VINYL	PAINT	PAINT	PAINT	PAINT	YES	NO	-
PODCAST STUDIO	156	CARPET	VINYL	PAINT	PAINT	PAINT	PAINT	YES	YES	-
HALLWAY	156A	CARPET	VINYL	PAINT	PAINT	PAINT	PAINT	YES	YES	-
OFFICE	162	LVT	VINYL	PAINT	PAINT	PAINT	PAINT	YES	NO	-
OFFICE	163	LVT	VINYL	PAINT	PAINT	PAINT	PAINT	YES	NO	-
OFFICE	164	EXIST TO REMAIN	EXIST TO REMAIN	EXIST TO REMAIN	EXIST TO REMAIN	EXIST TO REMAIN	EXIST TO REMAIN	EXIST TO REMAIN	NO	-
OFFICE	165	EXIST TO REMAIN	EXIST TO REMAIN	EXIST TO REMAIN	EXIST TO REMAIN	EXIST TO REMAIN	EXIST TO REMAIN	EXIST TO REMAIN	NO	-
BREAK ROOM	167	1 EXIST TO REMAIN	EXIST TO REMAIN	EXIST TO REMAIN	EXIST TO REMAIN	EXIST TO REMAIN	EXIST TO REMAIN	EXIST TO REMAIN	NO	-
COMPUTER ROOM	168	LVT	VINYL	PAINT	PAINT	PAINT	PAINT	YES	NO	-
CORRIDOR	169	CARPET	VINYL	PAINT	PAINT	PAINT	PAINT	YES	NO	-
ENTRANCE 2	170	CARPET	VINYL	PAINT	PAINT	PAINT	PAINT	YES	NO	-

FINISH LEGEND

FLOOR FINISH

LVT	LUXURY VINYL FLOOR TILE
SEALED CONCRETE	SEALED CONCRETE FINISH
PORCELAIN	PORCELAIN TILE-COLORSTORY-CONCRETE LOOK 12X24 FLOOR BY AMERICAN OLEAN OR EQUIVALENT
TILE-1	QUARRY TILE, 6"X6" BY DALTILE OR EQUAVALENT 1
CARPET	CARPET TILES

BASE

VINYL	VINYL COVE BASE-6" HIGH-BLACK
PORCELAIN	PORCELAIN COVE BASE-6" HIGH-COLORSTORY BY AMERICAN OLEAN OR EQUIVALENT
TILE-1	QUARRY TILE-5" HIGH-COVE BASE BY DALTILE OR EQUIVALENT
FRP	FRP BASE-4" HIGH 1

WALLS


PAINT	LATEX, FLAT, BENJAMIN MOORE OR EQUAL
CERAMIC	CERAMIC TILE COLOR STORY BY AMERICAN OLEAN 8X24 AND ACCENT TILE 1
FRP	FIBER REINFORCED PLASTIC WALL PANELS OVER DRYWALL
TILE	CERAMIC WALL TILE

CEILING


ACT	SUSPENDED ACOUSTICAL CEILING TILE
METAL	SUSPENDED ACOUSTICAL LINEAR METAL CEILING SYSTEM (WOOD FINISH)

ROOM FINISH NOTES:


1. REFER TO MECHANICAL AND ELECTRICAL DRAWINGS FOR DUCTS, DIFFUSER LOCATIONS, CEILING MOUNTED LIGHTS, SWITCHES AND CONTROLS.
2. DO NOT PAINT NON-FERROUS ITEMS LIKE ALUM. AND STAINLESS STEEL UNLESS NOTED ON CONTRACT DRAWINGS.
3. ALL COLORS/FINISHES SHALL BE SELECTED BY ARCHITECT AND APPROVED BY OWNER.
4. CONTRACTOR SHALL PROVIDE SAMPLES OF EACH FINISHES EITHER ON WALLS OR FLOOR FOR APPROVAL BY OWNER.
5. INSTALL SIGNAGE AT EVERY ROOM, ADJACENT TO DOOR, WALLS AND AT FOUR LOCATIONS AT THE EXTERIOR OF THE BUILDING TO INDICATE ROOM NUMBER, NAME, OCCUPANCY AND OTHER TEXTS. ALL LOCATIONS AND TEXT SHALL BE VERIFIED BY THE OWNER.
6. SEE DRAWING A8 FOR WOMAN'S ROOM FLOOR AND WALL FINISHES. 1

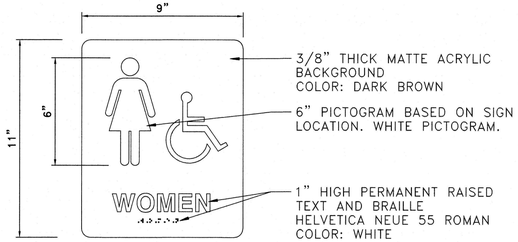


8 SIGN TYPE C
SCALE: 3" = 1'-0"

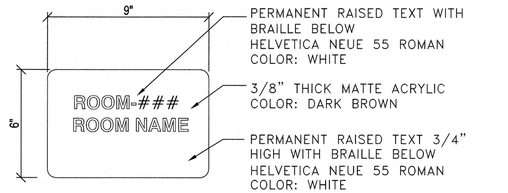


7 SIGN TYPE D
SCALE: 3" = 1'-0"

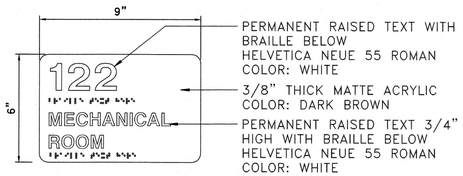


5 SIGN TYPE A
SCALE: 3" = 1'-0"

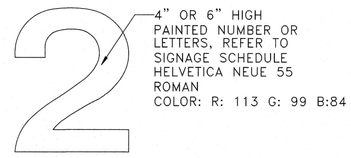


6 SIGN TYPE B
SCALE: 3" = 1'-0"

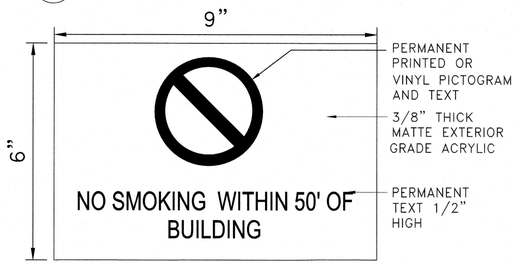


4 SIGN TYPE E
SCALE: 6" = 1'-0"

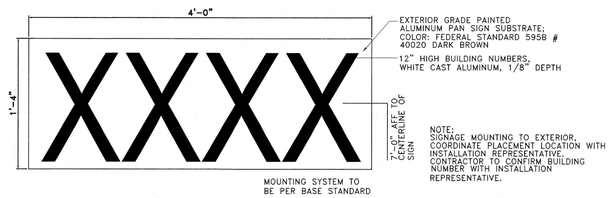

3 SIGN TYPE F
SCALE: 1-1/2" = 1'-0"

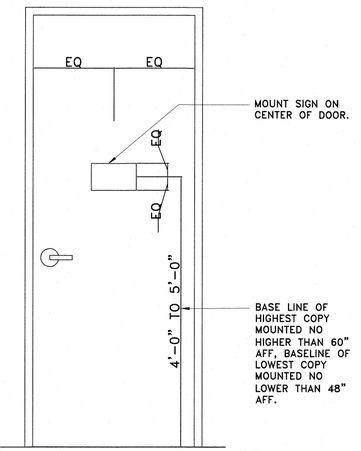

2 TYPICAL INTERIOR SIGN INSTALLATION - DOOR
SCALE: 3/4" = 1'-0"

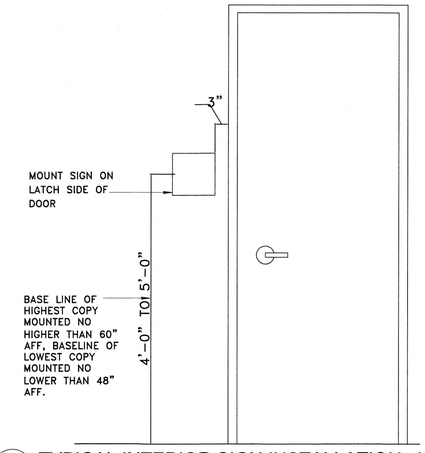

1 TYPICAL INTERIOR SIGN INSTALLATION - WALL
SCALE: 3/4" = 1'-0"

ISSUED FOR BID-9/25/26

APPROVED
William R. Long
PROFESSIONAL ENGINEER
NEW JERSEY LICENSE NO. 33012
11.12.25

APPROVED
Anita S. Aradhya
REGISTERED ARCHITECT
NEW JERSEY LICENSE NO. 18769

REVISIONS	DATE	BY
1 ADDENDUM #2	10/30/25	AA
2 ADDENDUM #5	11/12/25	AA

Tri-State Architects, P.C. / Alaimo Group
LIC. 33012
LIC. 18769
WILLIAM R. LONG, P.E.
ANITA S. ARADHYA, R.A.
200 HIGH STREET
MOUNT HOLLY, N.J.

DATE: AUG. 2026
DESIGNED BY: AA
DRAWN BY: AA
CHECKED BY:
DEPT. HEAD:

CLIENT: WILLINGBORO TOWNSHIP
PROJECT LOCATION: WILLINGBORO TWP. BURLINGTON COUNTY NEW JERSEY
PROJECT NO.: M-0410-0011-000
CONTRACT NO.: BIDR8-2026

KENNEDY CENTER
RENOVATION TO THE SENIOR CENTER


ROOM FINISH SCHEDULE AND DETAILS

SCALE: AS NOTED

SHEET
A20

FILE NO.:

Plotted: 11/11/2026 12:10 PM Last saved: 11/11/2026 12:08 PM File Name: M:\Projects\M0410001\1000\Drawings\CLG-A19-A20 Rm Fn & Door Schedule.dwg

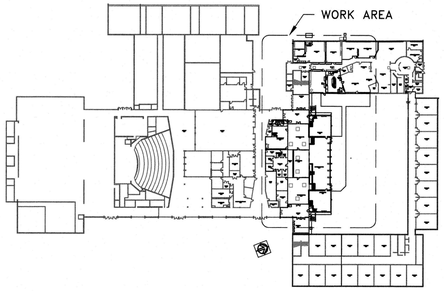

KEY PLAN


SCALE: N.T.S.

GENERAL DEMOLITION NOTES:

1. EXISTING CONDITIONS SHOWN ARE BASED ON RECORD PLANS AND SITE OBSERVATIONS. PRESENTATION OF AVAILABLE INFORMATION ON THESE DRAWINGS IN NO WAY IMPLIES ITS COMPLETENESS OR ACCURACY. THE CONTRACTOR IS RESPONSIBLE FOR THE FIELD MEASUREMENT OF ALL EXISTING ITEMS AND FOR VERIFYING THE ACCURACY OF THE INFORMATION PRESENTED HEREIN.
2. ELEVATIONS AND DIMENSIONS WERE TAKEN FROM DESIGN PLAN SET ENTITLED, "JOHN FITZGERALD KENNEDY HIGH SCHOOL", DATED JULY 1964, PREPARED BY PERKINS AND WILL.
3. BRING ANY DISCREPANCY OBSERVED IN DRAWINGS AND IN FIELD TO NOTICE OF ENGINEER PRIOR DEMOLITION.
4. DEMOLITION OF CONCRETE SLABS, MASS CONCRETE STAITS AND LANDING SHALL BE PERFORMED BY SAW-CUT DEMOLITION AND GRINDING. NO HEAVY JACK-HAMMERING IS ALLOWED.
5. CONTRACTOR SHALL LEGALLY DISPOSE OF DEMOLISHED ITEMS IN A MANNER ACCEPTABLE BASED ON THE NEW JERSEY DEPARTMENT OF ENVIRONMENTAL PROTECTION (NJDEP) REGULATIONS.
6. FOR OTHER DEMOLITION NOTES AND DEMOLITION OF NON-STRUCTURAL ELEMENTS AND EQUIPMENT SEE D-SERIES DRAWINGS.

GENERAL NOTES:

1. EXISTING CONDITIONS SHOWN ARE BASED ON RECORD PLANS. PRESENTATION OF AVAILABLE INFORMATION ON THESE DRAWINGS IN NO WAY IMPLIES ITS COMPLETENESS OR ACCURACY. THE CONTRACTOR SHALL BE RESPONSIBLE FOR VERIFYING ALL DIMENSIONS AND ELEVATIONS PRIOR TO SUBMIT SHOP DRAWINGS AND ORDERING ANY EQUIPMENT. NO ALLOWANCES WILL BE MADE BY THE OWNER FOR ERRORS RELATED TO THE CONTRACTOR NOT VERIFYING AND CHECKING THE DIMENSIONS AND ELEVATIONS IN THE FIELD.
2. DETAILS ARE INTENDED TO DEPICT GENERAL CONSTRUCTION METHODS FOR THE STRUCTURE. CONTRACTOR SHALL BE RESPONSIBLE TO ESTABLISH AND VERIFY GEOMETRY AND POSSIBLE CONFLICTS WITH THE PROPOSED SCOPE OF WORK WITH ARCHITECTURAL, MECHANICAL, ELECTRICAL, AND PLUMBING COMPONENTS PRIOR TO CONSTRUCTION. IF EXISTING CONDITIONS CONFLICT WITH CONTRACT DOCUMENTS, NOTIFY ENGINEER OF RECORD FOR CLARIFICATION IN A TIMELY MANNER. DO NOT DEVIATE FROM THE CONSTRUCTION DOCUMENTS WITHOUT INSTRUCTION FROM ENGINEER OF RECORD.
2. STRUCTURAL MEMBERS SIZES AND REINFORCING SHOWN HAVE BEEN DESIGNED TO SUIT THE EQUIPMENT SPECIFIED AND ARE THE MINIMUM ACCEPTABLE. SHOULD ALTERNATE EQUIPMENT BE USED, ANY DIMENSIONAL CHANGES MADE TO COMPLETE INSTALLATION SHALL BE DONE AT THE CONTRACTOR'S EXPENSE AND SHALL BE SIGNED AND SEALED BY A PROFESSIONAL ENGINEER LICENSED IN THE STATE OF NEW JERSEY.
6. DIMENSIONS AND ELEVATIONS ARE BASED ON DESIGN PLAN SET ENTITLED ""JOHN FITZGERALD KENNEDY HIGH SCHOOL", DATED JULY 1964, PREPARED BY PERKINS AND WILL.
4. ALL CONCRETE SHALL BE CLASS E CONCRETE AND SHALL CONTAIN FIBERMESH 150 @ 1.5 lb/CY BY PROPEX CONCRETE SYSTEMS OR EQUAL.
5. FOR TYPICAL MASONRY AND CONCRETE DETAILS AND NOTES, SEE SHEET S9.
7. FOR GENERAL STRUCTURAL STEEL NOTES AND DETAILS, SEE SHEET S10.
8. REFER TO M & E-SERIES DRAWINGS FOR PIPING, MECHANICAL AND ELECTRICAL ARRANGEMENTS AND DETAILS.
9. DRILLED IN ADHESIVE ANCHORS SHALL BE HILTI STAINLESS STEEL TYPE 316 HAS-R THREADED RODS WITH NUT AND WASHER INSTALLED WITH HILTI HIT-HY 200 ADHESIVE OR EQUAL. MINIMUM EMBEDMENT AS SHOWN ON DRAWINGS.
10. ALL ADHESIVE ANCHORS AND REBARS SHALL BE INSTALLED ACCORDANCE WITH MANUFACTURER'S INSTRUCTIONS.
11. FOR GUARDRAIL AND HANDRAIL, SEE A-SERIES DRAWINGS.
12. ANY ALUMINUM IN CONTACT WITH CONCRETE, GROUT OR DISSIMILAR METALS SHALL HAVE THE CONTACT SURFACE COATED WITH TWO (2) COATS OF A BITUMINOUS PAINT OR PROTECTED WITH MYLAR ISOLATORS, ⅛" THK. PTFE ISOLATORS SHEET OR OTHER APPROVED MATERIAL.

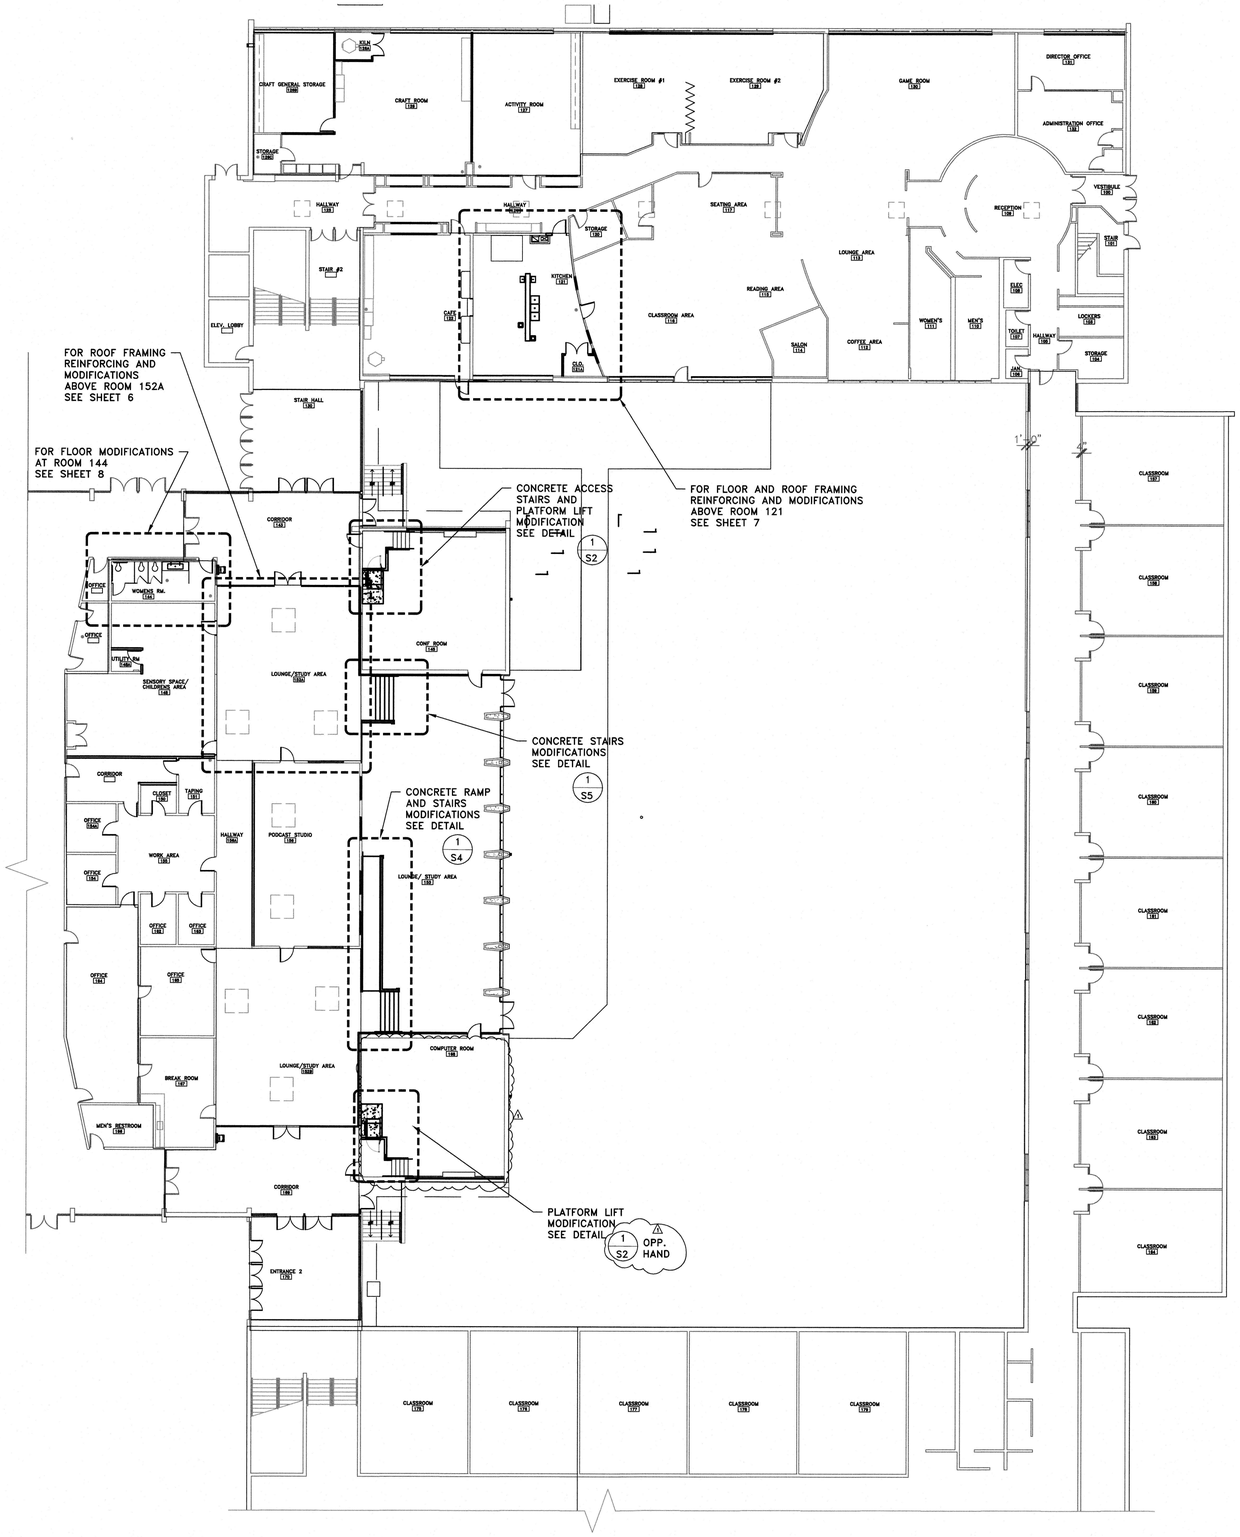

1 OVERALL FLOOR PLAN

SCALE : 1/16"=1'0"

ISSUED FOR BID-9/25/26

APPROVED
William R. Long
PROFESSIONAL ENGINEER
NEW JERSEY LICENSE NO. 33012

APPROVED
Anita S. Aradhya
REGISTERED ARCHITECT
NEW JERSEY LICENSE NO. 18769

BY	DATE	REVISIONS
PG	11/26/25	ADDENDUM #5

Tri-State Architects, P.C. / Alaimo Group

LIC. 33012
LIC. 18769

DATE:	AUG. 2026
DESIGNED BY:	PG
DRAWN BY:	PG
CHECKED BY:	
DEPT. HEAD:	

WILLIAM R. LONG, P.E.
ANITA S. ARADHYA, R.A.

200 HIGH STREET
MOUNT HOLLY, N.J.

CLIENT: WILLINGBORO TOWNSHIP

PROJECT LOCATION: WILLINGBORO TWP. BURLINGTON COUNTY NEW JERSEY

PROJECT NO.: M-0410-0011-000
CONTRACT NO.: BID#8-2026

KENNEDY CENTER
RENOVATION TO THE SENIOR CENTER


OVERALL FLOOR PLAN

SCALE: AS NOTED

SHEET
S1


FILE NO.:

Plotted: 11/5/2026 3:20 PM Last saved: 11/5/2026 3:17 PM File Name: M:\Projects\M0410001000\Drawings\GLO-S1-Overall Floor Plan.dwg

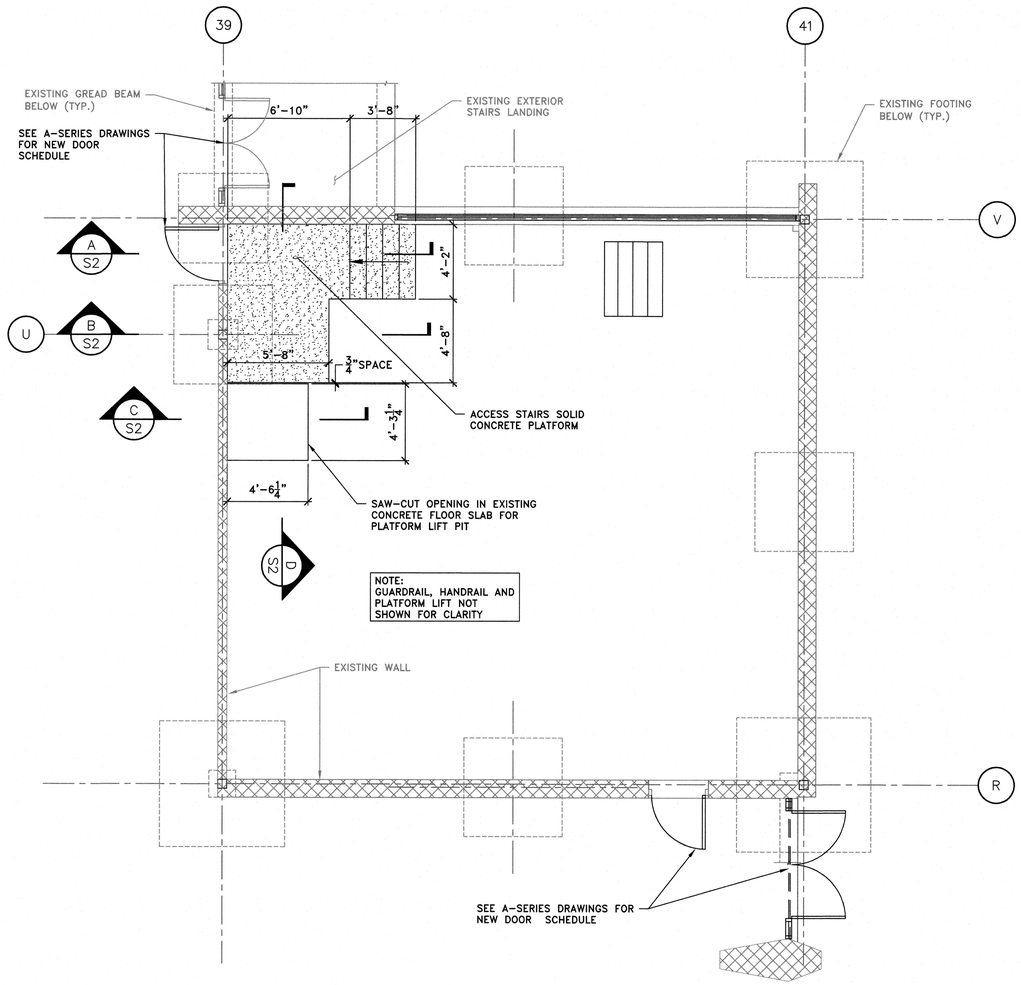


DETAIL 1 — ACCESS STAIRS AND PLATFORM LIFT PLAN
SCALE: 1/4" = 1'-0"

TEEN ROOM #145

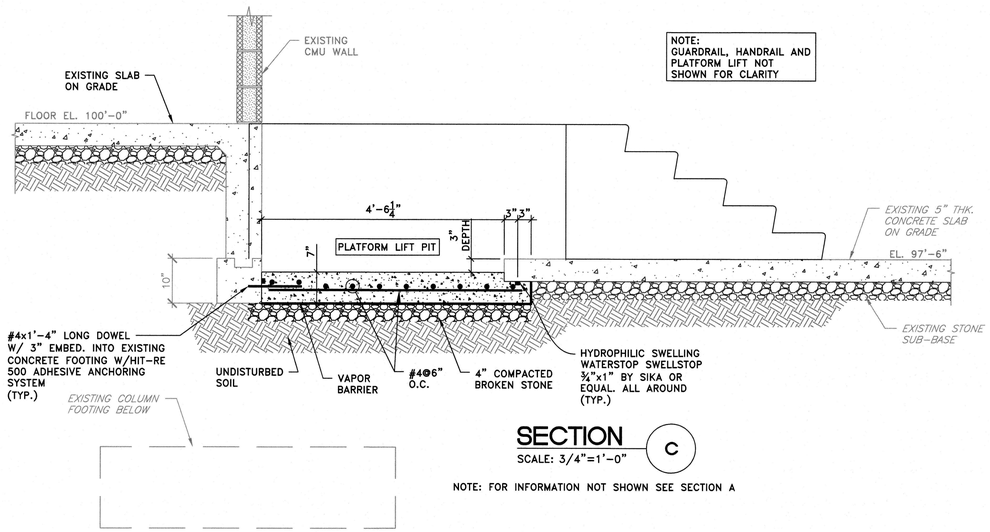


SECTION C
SCALE: 3/4"=1'-0"

NOTE: FOR INFORMATION NOT SHOWN SEE SECTION A

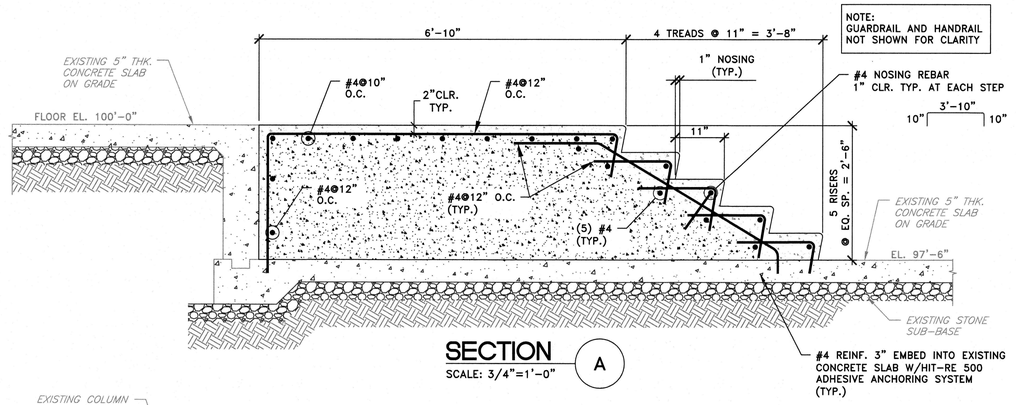


SECTION A
SCALE: 3/4"=1'-0"

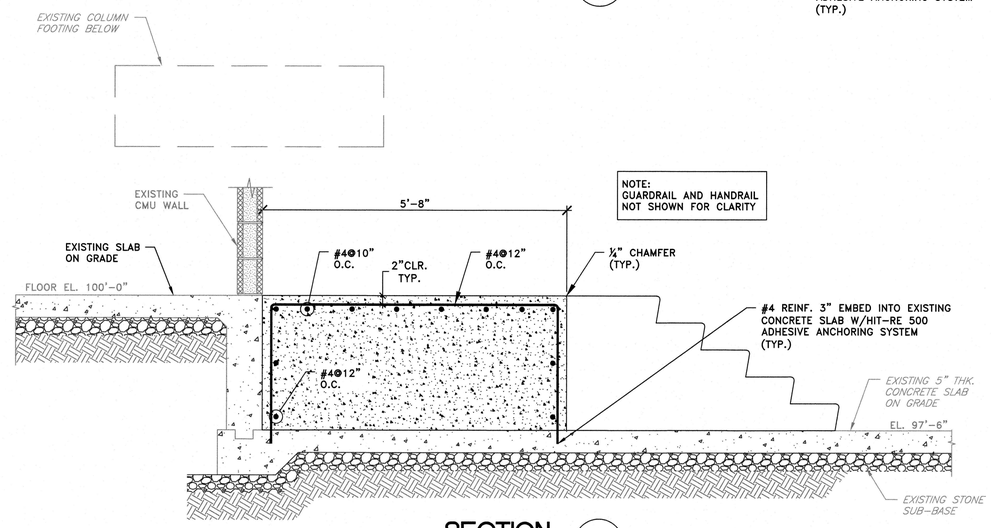

SECTION B
SCALE: 3/4"=1'-0"

NOTE: FOR INFORMATION NOT SHOWN SEE SECTION A

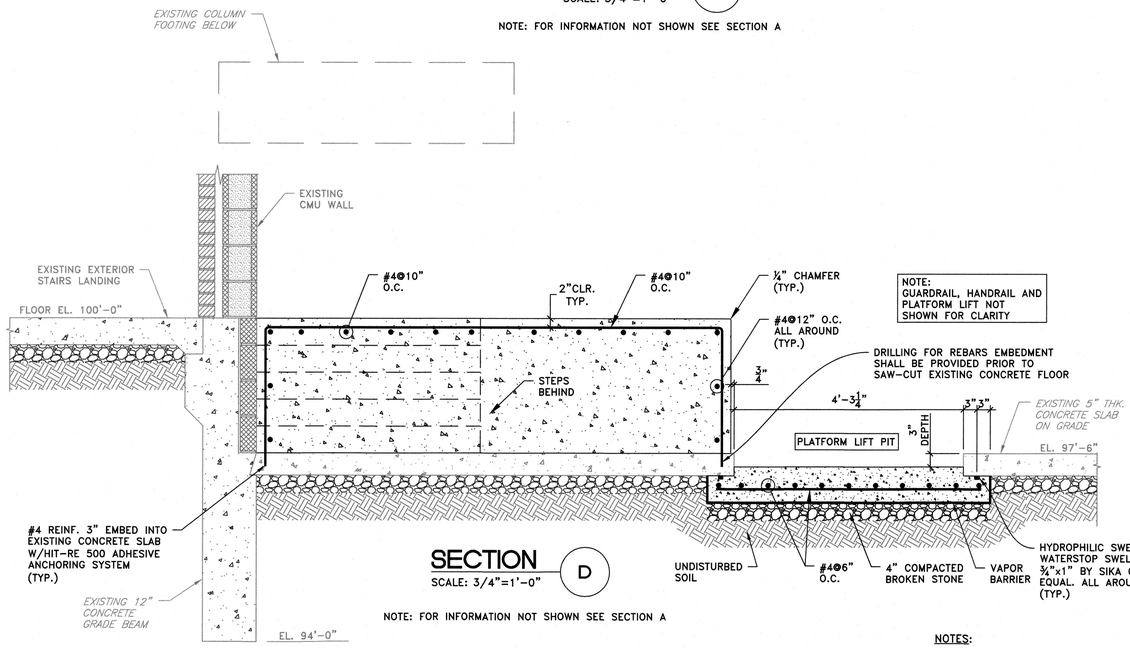

SECTION D
SCALE: 3/4"=1'-0"

NOTE: FOR INFORMATION NOT SHOWN SEE SECTION A

NOTES:

1. SEE GENERAL NOTES ON SHEET S1.

ISSUED FOR BID-9/25/26

APPROVED 11.12.26
William R. Long
PROFESSIONAL ENGINEER
NEW JERSEY LICENSE NO. 33012

APPROVED
Anita S. Aradhya
REGISTERED ARCHITECT
NEW JERSEY LICENSE NO. 18769

BY	DATE	REVISIONS

Tri-State Architects, P.C. / Alaimo Group
WILLIAM R. LONG, P.E. LIC. 33012
ANITA S. ARADHYA, R.A. LIC. 18769
200 HIGH STREET MOUNT HOLLY, N.J.

DATE: AUG. 2026
DESIGNED BY: PG
DRAWN BY: PG
CHECKED BY:
DEPT. HEAD:


CLIENT: WILLINGBORO TOWNSHIP
PROJECT LOCATION: WILLINGBORO TWP. BURLINGTON COUNTY NEW JERSEY
PROJECT NO.: M-0410-0011-000
CONTRACT NO.: BID#8-2026

KENNEDY CENTER RENOVATION TO THE SENIOR CENTER
ROOM #145 MODIFICATIONS
SCALE: AS NOTED

SHEET
S2

FILE NO.:

Plotted: 11/5/2026 3:55 PM Last saved: 11/5/2026 2:56 PM File Name: M:\Projects\M0410001000\Drawings\OLD-S2-Room #145 Modifications ADDS.dwg

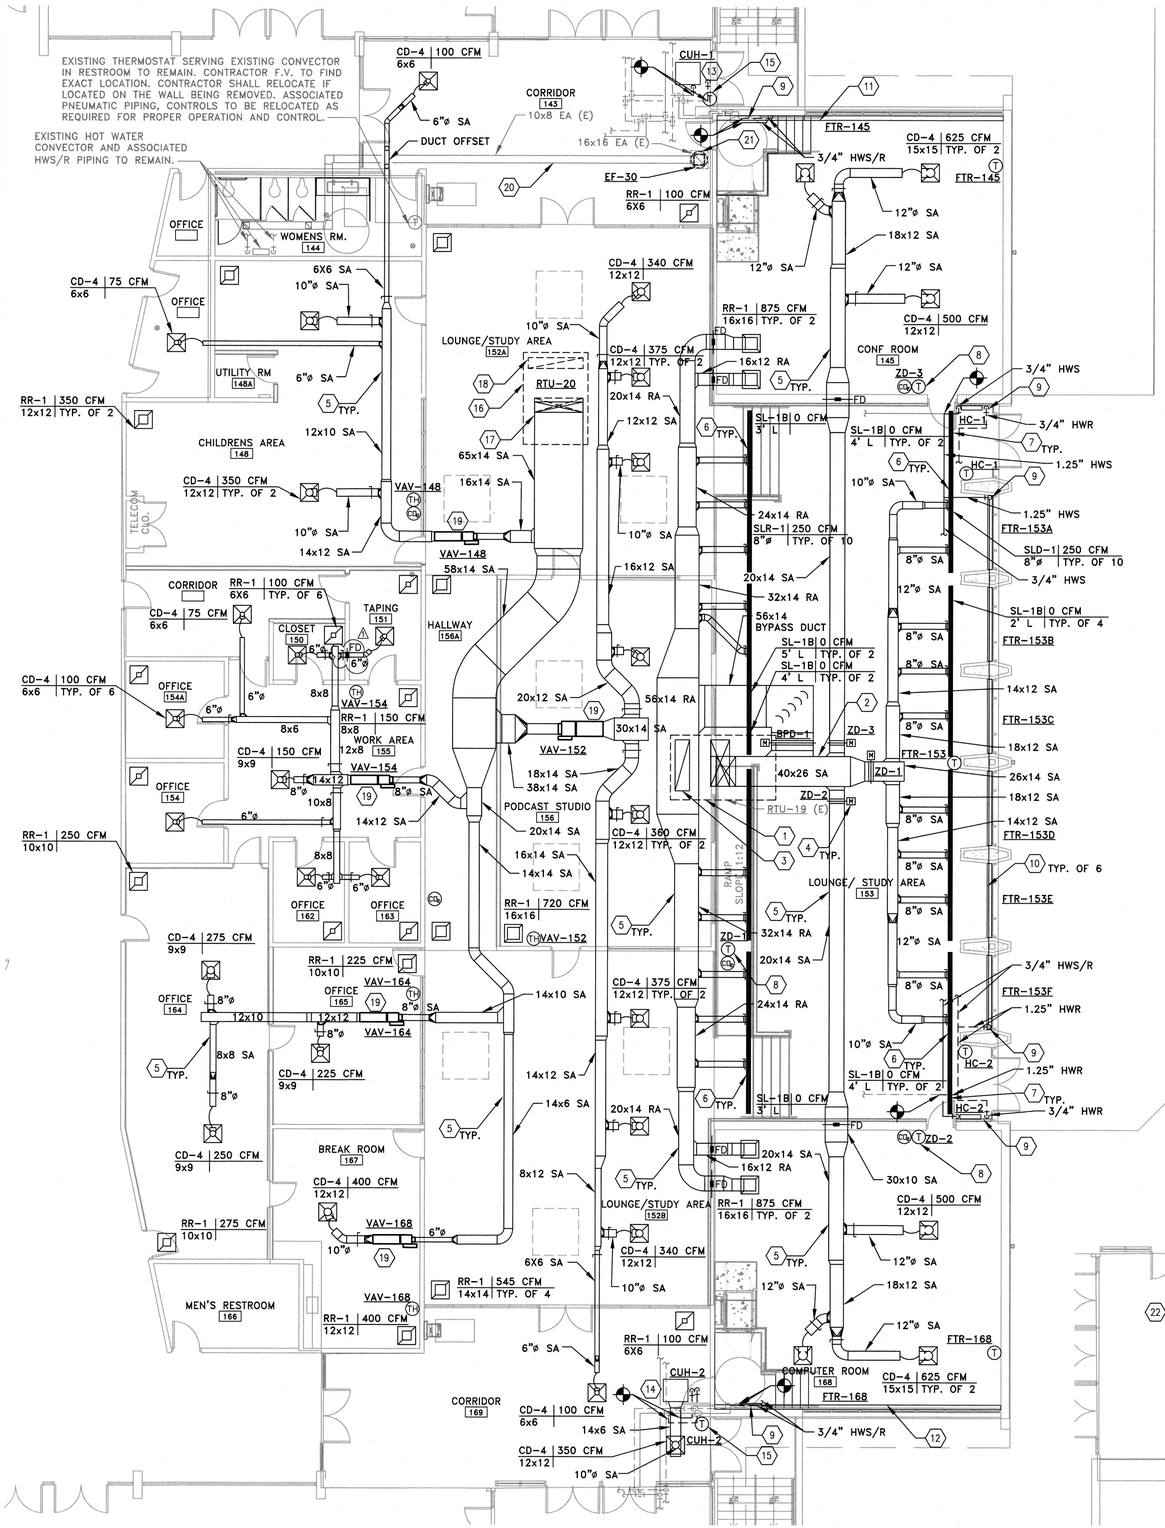
EXISTING THERMOSTAT SERVING EXISTING CONVECTOR IN RESTROOM TO REMAIN. CONTRACTOR F.V. TO FIND EXACT LOCATION. CONTRACTOR SHALL RELOCATE IF LOCATED ON THE WALL BEING REMOVED. ASSOCIATED PNEUMATIC PIPING, CONTROLS TO BE RELOCATED AS REQUIRED FOR PROPER OPERATION AND CONTROL.
EXISTING HOT WATER CONVECTOR AND ASSOCIATED HWS/R PIPING TO REMAIN.
OFFICE
WOMENS' RM. 144
CD-4 | 75 CFM 6x6
OFFICE
UTILITY RM 148A
RR-1 | 350 CFM 12x12 | TYP. OF 2
CHILDRENS AREA 148
CD-4 | 350 CFM 12x12 | TYP. OF 2
TELECOM CLO.
CORRIDOR 143
10x8 EA (E)
16x16 EA (E)
CD-4 | 100 CFM 6x6
6"ø SA
DUCT OFFSET
CUH-1
EF-30
RR-1 | 100 CFM 6X6
6X6 SA
10"ø SA
12x10 SA
VAV-148
14x12 SA
10"ø SA
VAV-148
58x14 SA
LOUNGE/STUDY AREA 152A
RTU-20
65x14 SA
16x14 SA
CD-4 | 340 CFM 12x12
CD-4 | 375 CFM 12x12 | TYP. OF 2
20x14 RA
12x12 SA
10"ø SA
16x12 RA
24x14 RA
SLR-1 | 250 CFM 8"ø | TYP. OF 10
20x14 SA
32x14 RA
56x14 BYPASS DUCT
SL-1B | 0 CFM 3' L
SL-1B | 0 CFM 4' L | TYP. OF 2
SL-1B | 0 CFM 5' L | TYP. OF 2
SL-1B | 0 CFM 4' L | TYP. OF 2
RR-1 | 875 CFM 16x16 | TYP. OF 2
CD-4 | 500 CFM 12x12
CONF ROOM 145
ZD-3
FTR-145
CD-4 | 625 CFM 15x15 | TYP. OF 2
3/4" HWS/R
12"ø SA
18x12 SA
12"ø SA
12"ø SA
3/4" HWS
3/4" HWR
1.25" HWS
HC-1
TYP.
10"ø SA
1.25" HWS
FTR-153A
SLD-1 | 250 CFM 8"ø | TYP. OF 10
3/4" HWS
8"ø SA
12"ø SA
SL-1B | 0 CFM 2' L | TYP. OF 4
FTR-153B
8"ø SA
8"ø SA
14x12 SA
FTR-153C
8"ø SA
18x12 SA
FTR-153
26x14 SA
14x12 SA
FTR-153D
8"ø SA
TYP. OF 6
FTR-153E
8"ø SA
12"ø SA
3/4" HWS/R
FTR-153F
1.25" HWR
HC-2
10"ø SA
1.25" HWR
3/4" HWR
TYP.
HC-2
ZD-2
30x10 SA
CD-4 | 500 CFM 12x12
12"ø SA
18x12 SA
12"ø SA
FTR-168
CD-4 | 625 CFM 15x15 | TYP. OF 2
FTR-168
3/4" HWS/R
CORRIDOR 143
RR-1 | 100 CFM 6X6 | TYP. OF 6
CD-4 | 75 CFM 6x6
TAPING 151
CLOSET 150
HALLWAY 156A
CD-4 | 100 CFM 6x6 | TYP. OF 6
OFFICE 154A
6"ø
8x8
VAV-154
RR-1 | 150 CFM 8x8
WORK AREA 12x8 155
CD-4 | 150 CFM 9x9
VAV-154
14x12
OFFICE 154
6"ø
RR-1 | 250 CFM 10x10
8x8
6"ø
6"ø
OFFICE 162
OFFICE 163
PODCAST STUDIO 156
20x14 SA
16x14 SA
14x14 SA
RR-1 | 720 CFM 16x16
VAV-152
18x14 SA
38x14 SA
VAV-152
20x12 SA
56x14 RA
30x14 SA
CD-4 | 360 CFM 12x12 | TYP. OF 2
RAMP SLOPE 1:12
LOUNGE/ STUDY AREA 153
TYP.
32x14 RA
20x14 SA
ZD-1
CD-4 | 275 CFM 9x9
RR-1 | 225 CFM 10x10
VAV-164
OFFICE 164
OFFICE 165
8"ø
12x10
12x12
8"ø SA
VAV-164
8"ø
8x8 SA
8"ø
CD-4 | 225 CFM 9x9
CD-4 | 250 CFM 9x9
CD-4 | 375 CFM 12x12 | TYP. OF 2
24x14 RA
SL-1B | 0 CFM 3' L
14x10 SA
14x12 SA
14x6 SA
TYP.
20x14 RA
TYP.
BREAK ROOM 167
CD-4 | 400 CFM 12x12
RR-1 | 275 CFM 10x10
VAV-168
6"ø
10"ø
8x12 SA
LOUNGE/STUDY AREA 152B
RR-1 | 875 CFM 16x16 | TYP. OF 2
CD-4 | 340 CFM 12x12
10"ø SA
6X6 SA
RR-1 | 545 CFM 14x14 | TYP. OF 4
MEN'S RESTROOM 166
VAV-168
RR-1 | 400 CFM 12x12
6"ø SA
RR-1 | 100 CFM 6X6
CUH-2
CORRIDOR 169
CD-4 | 100 CFM 6x6
14x6 SA
CD-4 | 350 CFM 12x12
10"ø SA
CUH-2
3/4" HWS/R
COMPUTER ROOM 168
CD-4 | 625 CFM 15x15 | TYP. OF 2
FTR-168
ZD-1
ZD-2
RTU-19 (E)
BPD-1
ZD-3
40x26 SA
ZD-1
ZD-2
TYP.
TYP. OF 6
TYP.
TYP.
TYP.

GENERAL ELECTRICAL NOTES:

1. ALL ELECTRICAL WORK SHALL BE IN ACCORDANCE WITH THE LATEST ADAPTATION OF THE NATIONAL ELECTRICAL CODE (NEC). ALL WORK SHALL BE PERFORMED BY A NEW JERSEY LICENSED ELECTRICAL CONTRACTOR.

2. ALL EQUIPMENT, MATERIALS, INSTALLATION AND CONSTRUCTION ACTIVITIES SHALL COMPLY WITH ALL REQUIREMENTS OF THE OCCUPATIONAL SAFETY AND HEALTH ADMINISTRATION WHEREVER THEY APPLY.

3. ELECTRICAL CONTRACTOR SHALL COORDINATE WITH EQUIPMENT MANUFACTURERS FOR ELECTRICAL SCOPE OF CONSTRUCTION.

4. CONTRACTOR SHALL COORDINATE HIS WORK WITH THAT OF OTHER CONTRACTORS ON THE PROJECT, PRIOR TO ROUGHING-IN. CONTRACTOR SHALL REVIEW AND OBTAIN ACCURATE DATA/INFORMATION FROM APPROVED SHOP DRAWINGS OF OTHER TRADES INVOLVED.

5. CONTRACTOR SHALL FIELD VERIFY ALL EXISTING CONDITIONS AND RECORD ALL CURRENT INSTALLATION AND TERMINATIONS PRIOR TO THE INSTALLATION OR REMOVAL OF ANY EQUIPMENT. CONTRACTOR SHALL FIELD VERIFY EXACT LOCATION OF CONDUITS, ROUTING, BOXES, CIRCUITS AND EQUIPMENT ENSURE AS-BUILT CONDITIONS ARE CORRECT AS INDICATED ON PLANS PRIOR TO CONSTRUCTION.

6. ALL CONDUIT RUNS ARE DIAGRAMMATICALLY SHOWN ON THE DRAWINGS. THE FINAL ROUTING OF CONDUITS SHALL BE DETERMINED BY THE ELECTRICAL CONTRACTOR AND APPROVED BY THE ENGINEER. CONDUIT SHALL BE INSTALLED IN A MANNER TO PREVENT CONFLICTS WITH EQUIPMENT AND STRUCTURAL CONDITIONS. EXPOSED CONDUITS SHALL BE INSTALLED PARALLEL TO BEAMS AND WALLS. CONDUIT SHALL BE TERMINATED SO AS TO PERMIT NEAT CONNECTIONS TO EQUIPMENT.

7. THE POWER AND CONTROL WIRING SHALL BE STRANDED COPPER CONDUCTOR WITH XHHW INSULATION RATED 600 VOLTS.

8. THE ELECTRICAL CONTRACTOR SHALL FURNISH AND INSTALL A COMPLETE GROUNDING SYSTEM IN ACCORDANCE WITH THE NATIONAL ELECTRICAL CODE. ELECTRICAL WIRE RACEWAYS, APPARATUS AND PANEL ENCLOSURES AND OTHER NON-CURRENT CARRYING METAL PARTS SHALL BE MECHANICALLY JOINED TO FORM A CONTINUOUS CONDUCTING METALLIC PATH AND ASSURE ELECTRICAL CONTINUITY OF THE GROUNDING CIRCUITS. THE STRANDED COPPER BONDING JUMPER CABLES AND/OR GROUND WIRES SHALL BE INSTALLED WHERE REQUIRED. THE SURFACE WHERE GROUNDING CONNECTIONS ARE TO BE MADE SHALL BE CLEAN AND DRY. STEEL SURFACES SHALL BE GROUND OR FILED TO REMOVE ALL SCALE, RUST, GREASE AND DIRT. COPPER AND GALVANIZED STEEL SHALL BE CLEANED WITH EMERY CLOTH TO REMOVE OXIDE BEFORE MAKING CONNECTIONS. ALL EQUIPMENT, STRUCTURES AND SUPPLEMENTAL GROUNDINGS FOR FOUNDATIONS SHALL BE FURNISHED AND INSTALLED PER THE NEC AND EQUIPMENT MANUFACTURER.

9. ALL FIELD WIRING TERMINATIONS SHALL BE MADE AT TERMINALS LOCATED IN THE INDIVIDUAL COMPARTMENTS OR ENCLOSURES. USE OF WIRE NUTS OR DIRECT WIRING WILL NOT BE ACCEPTED. ALL TERMINATION POINTS MUST BE IDENTIFIED IN THE SHOP DRAWINGS AND PERMANENTLY / CLEARLY MARKED IN ACCORDANCE WITH THE SPECIFICATION REQUIREMENTS. TERMINATOR MATERIALS SHALL BE SIZED FOR THE INSTALLED CONDUCTORS.

10. ALL WIRES SHALL BE NEATLY BUNDLED AND TAGGED TO INDICATE THE CONNECTED DEVICE. EACH WIRE SHALL BE COLOR CODED AND TAGGED WITH A PLASTIC SLEEVE TYPE WIRING TAG. WIRING SHALL BE TAGGED AT EACH POINT OF TERMINATION.

11. ALL DEVICES AND APPARATUS FURNISHED SHALL BE NEW AND SHALL BE UL LISTED.

12. THE WIRING DIAGRAMS, QUANTITY AND SIZE OF WIRES AND CONDUIT REPRESENT A SUGGESTED ARRANGEMENT BASED UPON SELECTED STANDARD COMPONENTS OF ELECTRICAL EQUIPMENT. MODIFICATIONS ACCEPTABLE TO THE ENGINEER MAY BE MADE BY THE CONTRACTOR TO ACCOMMODATE EQUIPMENT ACTUALLY PURCHASED. THE BASIC SEQUENCE AND METHOD OF CONTROL MUST BE MAINTAINED AS INDICATED ON THE DRAWINGS AND/OR SPECIFICATION.

13. CONTRACTOR SHALL FURNISH AND INSTALL ALL CIRCUIT BREAKERS, DISCONNECTS, AND FUSING PER MANUFACTURER RECOMMENDATIONS AND PER NEC CODE. ALL CIRCUIT BREAKERS AND DISCONNECTS FOR MOTOR-OPERATED EQUIPMENT SHALL BE EQUIPPED WITH LOCK-OUT / TAG-OUT ACCESSORY.

14. CONTRACTOR SHALL COORDINATE AND SCHEDULE SHUTDOWNS AT SUITABLE TIMES TO THE OWNER. OWNER AND CONTRACTOR SHALL JOINTLY LOCK OUT AND TAG OUT BREAKERS AND SWITCHES DURING SHUTDOWN PERIODS.

15. ALL NEW EQUIPMENT SHOWN IS PROPOSED APPROXIMATE LOCATION BASED ON MANUFACTURER SUPPLIED DOCUMENTS. ALL EXISTING EQUIPMENT SHOWN IS APPROXIMATE LOCATION BASED ON RECORD DRAWINGS AND FIELD OBSERVATION. CONTRACTOR SHALL FIELD VERIFY ALL DEVICE LOCATIONS PRIOR TO CONSTRUCTION.

16. CONTRACTOR SHALL PERFORM A SITE VISIT PRIOR TO BIDDING TO REVIEW ALL WORK REQUIRED. ANY EXISTING CONDITION FOUND WHICH WILL AFFECT WORK TO BE COMPLETED SHALL BE BROUGHT TO THE ATTENTION OF THE ENGINEER IN WRITING PRIOR TO BID DATE. CLAIMS FOR EXTRA WORK WILL NOT BE ALLOWED FOR ANY WORK THAT MAY BE CAUSED BY EXISTING CONDITIONS, IN WHICH SHOULD HAVE BEEN FORESEEN SUBSEQUENT TO THE JOB SITE VISIT.

17. EXISTING UNDERGROUND PIPE, CONDUIT AND APPURTENANCES ARE NOT SHOWN IN COMPLETE DETAIL. CONTRACTOR SHALL LOCATE ALL EXISTING SUBSURFACE EQUIPMENT WHICH MAY CONFLICT WITH NEW CONSTRUCTION SO AS TO AVOID CONFLICTS WITH OR DAMAGE TO EXISTING BELOW GRADE MATERIALS.

18. THE ELECTRICAL CONTRACTOR SHALL FURNISH AND INSTALL ALL WORK AS SHOWN ON THE CONTRACT DRAWINGS AND AS OUTLINED IN THE CONTRACT SPECIFICATIONS WITH THE FOLLOWING UNDERSTANDINGS:

18.1. THE CONTRACT DRAWINGS ARE ONLY DIAGRAMMATIC IN NATURE AND ARE INTENDED TO OUTLINE THE SYSTEMS TO BE PROVIDED. THEREFORE, MINOR DETAILS AND APPURTENANCES MAY OR MAY NOT BE SHOWN. THE OMISSION OF A MINOR COMPONENT SHALL NOT RELIEVE THE CONTRACTOR OF THEIR RESPONSIBILITY TO FURNISH AND INSTALL ALL SUCH ITEMS NECESSARY TO PROVIDE A COMPLETE, OPERATIVE, AND CODE COMPLIANT SYSTEM TO THE OWNER. IF THERE ARE ANY DOUBTS TO THE EXTENT OR SCOPE OF WORK REQUIRED THE ENGINEER SHALL BE CONTACTED TO PROVIDE CLARIFICATION DURING THE BID PHASE.

18.2. THE CONTRACT DRAWINGS SHOW INTENDED EQUIPMENT LOCATIONS. THE CONTRACTOR SHALL BE RESPONSIBLE FOR ANY MINOR ADJUSTMENTS OR RELOCATIONS NECESSARY DUE TO THE CHOICE OF EQUIPMENT AND COORDINATION CONFLICTS. ALL EQUIPMENT RELOCATIONS MUST BE APPROVED BY THE OWNER OR THE ENGINEER.

19. WORK UNDER THIS CONTRACT INCLUDES THE FURNISHING OF EQUIPMENT, MATERIAL, TOOLS, TRANSPORTATION, SERVICES, SCAFFOLDING, SUPERVISION, LABOR AND OTHER APPURTENANCES REQUIRED FOR THE FABRICATION, INSTALLATION, OR APPLICATION AND COMPLETION OF THE WORK UNDER THIS SECTION AS SHOWN OR AS IMPLIED ON THE CONTRACT DRAWINGS AND SPECIFICATIONS.


20. SEE SHEETS ED1 AND ED2 FOR DEMOLITION PLANS AND NOTES.

21. SEE A-SERIES PLANS FOR ARCHITECTURAL DETAILS, H-SERIES PLANS FOR MECHANICAL DETAILS, AND S-SERIES PLANS FOR STRUCTURAL DETAILS.

22. CONTRACTOR SHALL COORDINATE WITH OWNER'S IT REPRESENTATIVE, BELLIA TECHNOLOGIES, REGARDING ALL MATTERS CONCERNING THE INSTALLATION OF NETWORK EQUIPMENT AND SECURITY. CONTACT AT BELLIA TECHNOLOGIES: KEN BELLIA, KEN@BELLIATECH.COM, (856)202-7664.


23. CONTRACTOR SHALL COORDINATE WITH OWNER'S BUILDING MANAGEMENT SYSTEM REPRESENTATIVE, SCHNEIDER ELECTRICAL, FOR ALL CONTROLS INTEGRATION AND INSTALLATION. CONTACT AT SCHNEIDER ELECTRICAL: WILHELMUS PENNINGS, (717)460-5016.

24. RECEPTACLES TO BE FURNISHED AND INSTALLED IN EXISTING CMU WALLS AND ASSOCIATED WIRING SHALL BE RECESSED WITHIN CMU WALLS. CONTRACTOR IS RESPONSIBLE FOR MEANS AND METHODS IN ACCORDANCE WITH NEC AND ALL OTHER APPLICABLE CODES. 5

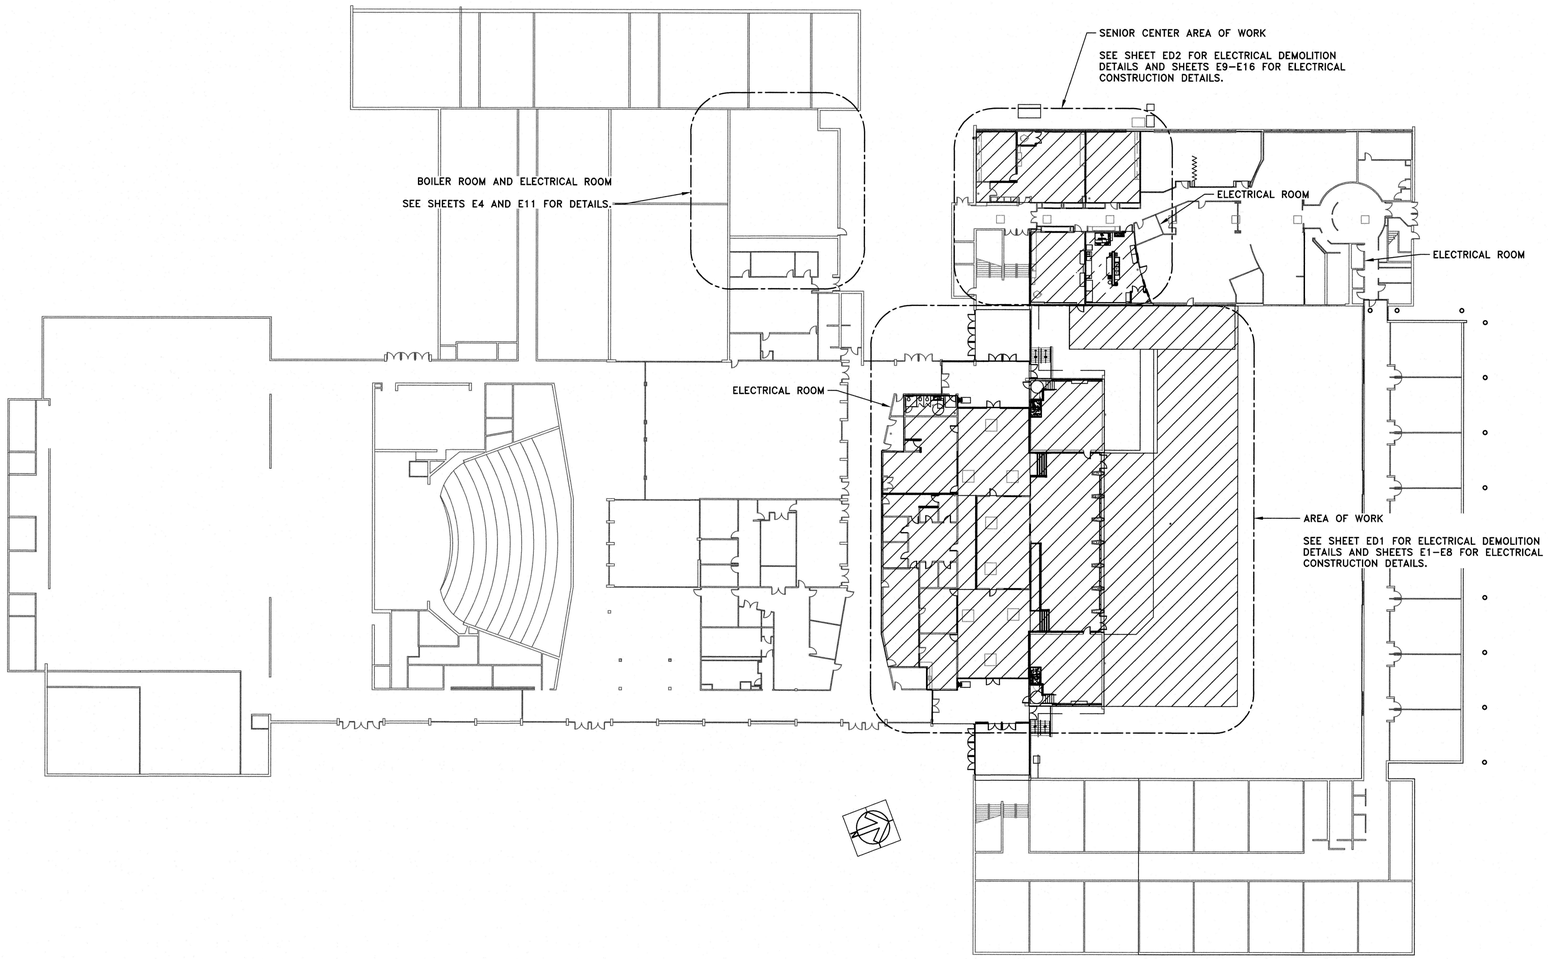

ELECTRICAL KEY PLAN

SCALE: 1/32" = 1'-0"

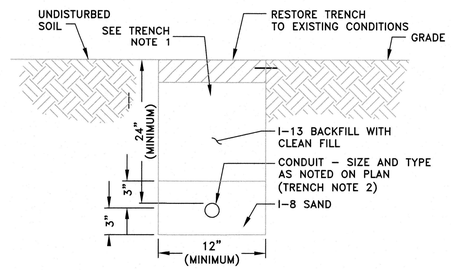

TRENCH DETAIL (TYPICAL)

SCALE: N.T.S.

1. DETECTABLE UNDERGROUND TAPE: "CAUTION BURIED ELECTRICAL LINE BELOW", RED TAPE WITH BLACK LETTERS, 6" x 1000 FEET, BRADY LABELS OR EQUIVALENT. BURY 6" (MINIMUM) BELOW GRADE. BURY TAPE DIRECTLY OVER SINGLE CONDUIT OR CENTER OF MULTIPLE CONDUITS UNLESS QUANTITY OF CONDUITS IN TRENCH EXCEEDS (5) FIVE CONDUITS, IN WHICH CASE USE (2) TWO TAPES CENTERED ON OUTER-MOST CONDUITS.
2. MAINTAIN AT LEAST 7" SEPARATION BETWEEN ADJACENT CONDUITS IN TRENCH AND 12" SEPARATION FROM ANY UNDERGROUND SERVICE CONDUITS/PIPE.

100% DRAWINGS-8-10-2026

APPROVED 11/12/26
William R. Long
PROFESSIONAL ENGINEER
NEW JERSEY LICENSE NO. 33012

APPROVED
Anita S. Aradhya
REGISTERED ARCHITECT
NEW JERSEY LICENSE NO. 18769

REVISIONS	DATE	BY
△ ADDENDUM NO. 5	11/11/26	KGK

Tri-State Architects, P.C. / Alaimo Group
WILLIAM R. LONG, P.E. LIC. 33012
ANITA S. ARADHYA, R.A. LIC. 18769
200 HIGH STREET MOUNT HOLLY, N.J.

DATE: AUG. 2026
DESIGNED BY: JRN/KMG
DRAWN BY: KMG
CHECKED BY:
DEPT. HEAD:

CLIENT: WILLINGBORO TOWNSHIP
PROJECT LOCATION: WILLINGBORO TWP. BURLINGTON COUNTY NEW JERSEY
PROJECT NO.: M-0410-0011-000
CONTRACT NO.: BID#8-2026

KENNEDY CENTER
RENOVATION TO THE SENIOR CENTER

ELECTRICAL KEY PLAN AND NOTES

SCALE: AS NOTED


SHEET
E0

FILE NO.:


Plotted: 11/11/2026 10:44 AM Last saved: 11/11/2026 10:43 AM File Name: M:\Projects\M0410001\000\Drawings\CLC-EC-Electrical Key Plan.dwg

ELECTRICAL CONSTRUCTION NOTES:

1. SEE SHEET E0 FOR ELECTRICAL KEY PLAN AND GENERAL ELECTRICAL NOTES.
2. CONTRACTOR SHALL FURNISH AND INSTALL NEW JUNCTION BOXES JBX–1 AND JBX–2 IN APPROXIMATE PLACE OF EXISTING PANELS L4A AND 'BROWSING & OUTSIDE LITES' TO BE DEMOLISHED. CONTRACTOR SHALL USE JUNCTION BOXES TO EXTEND EXISTING LOAD WIRING AND CONDUIT AS REQUIRED TO ENSURE ALL EXISTING SYSTEMS TO REMAIN ARE CONNECTED TO NEW POWER SOURCE VIA NEW LIGHTING PANELS. CONTRACTOR TO ENSURE ALL CIRCUITS THAT ARE NOT ASSOCIATED WITH EQUIPMENT TO BE DEMOLISHED IN THIS CONTRACT ARE EXTENDED AND CONNECTED TO NEW PANELS L4A AND H4B AS REQUIRED. SEE SHEETS E6 AND E7 FOR EXISTING AND NEW PANEL SCHEDULES. EXISTING CIRCUITS TO BE EXTENDED ARE SHOWN TO THE EXTENT OF AVAILABLE INFORMATION, THE CONTRACTOR IS RESPONSIBLE FOR ENSURING COMPLETE FUNCTIONALITY AND INTEGRITY OF SYSTEMS TO REMAIN.
3. CONDUITS TO EXTEND EXISTING CIRCUITS TO REMAIN FROM JUNCTION BOXES JBX–1 AND JBX–2 TO NEW PANEL SHALL BE ELECTRICAL METALLIC TUBING TYPE CONDUIT BELOW ACCESSIBLE CEILINGS, SIZED AS REQUIRED DURING CONSTRUCTION. MC CABLE USE IS PERMITTED ABOVE ACCESSIBLE CEILING. THE CIRCUITS ARE TO BE EXTENDED WITH COMPATIBLE MEANS AND TRACED TO THEIR SOURCE ON EITHER END TO ENSURE COMPLETE SYSTEM INTEGRITY AND FUNCTIONALITY AND TO PROVIDE THE OWNER WITH A COMPLETE/ACCURATE PANEL SCHEDULE.
4. CONTRACTOR SHALL PRESERVE AND RECONNECT EXISTING WIRING FEEDING PANEL H4A. CONTRACTOR SHALL EXTEND WITH COMPATIBLE MEANS AS REQUIRED, AND ENSURE THE INTEGRITY OF EXISTING WIRING TO REMAIN.
5. RECEPTACLES TO BE FURNISHED AND INSTALLED IN EXISTING CMU WALLS AND ASSOCIATED WIRING SHALL BE RECESSED WITHIN CMU WALLS. CONTRACTOR IS RESPONSIBLE FOR MEANS AND METHODS IN ACCORDANCE WITH NEC AND ALL OTHER APPLICABLE CODES.

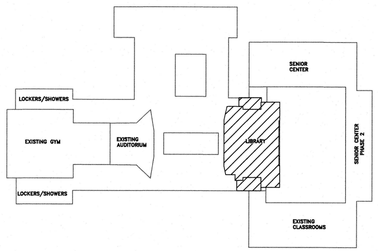


KEY PLAN
NOT TO SCALE

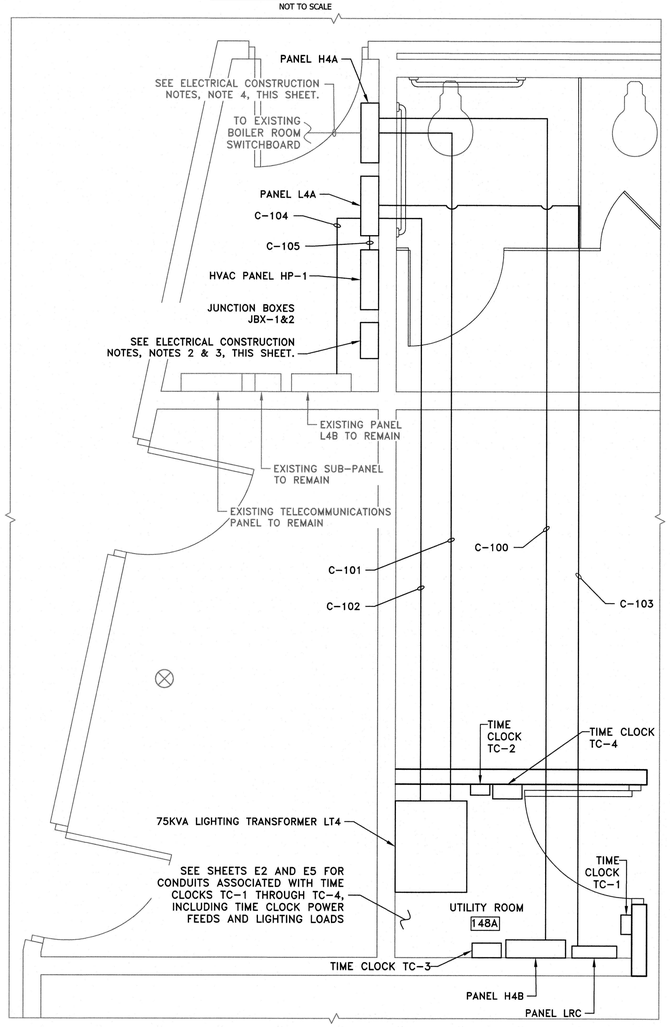

ELECTRICAL & UTILITY ROOM FLOOR PLAN
SCALE: 1/2" = 1'–0"

LEGEND:

- NEW DUPLEX RECEPTACLE
- NEW QUAD. RECEPTACLE
- NEW TELECOMMUNICATIONS PORT

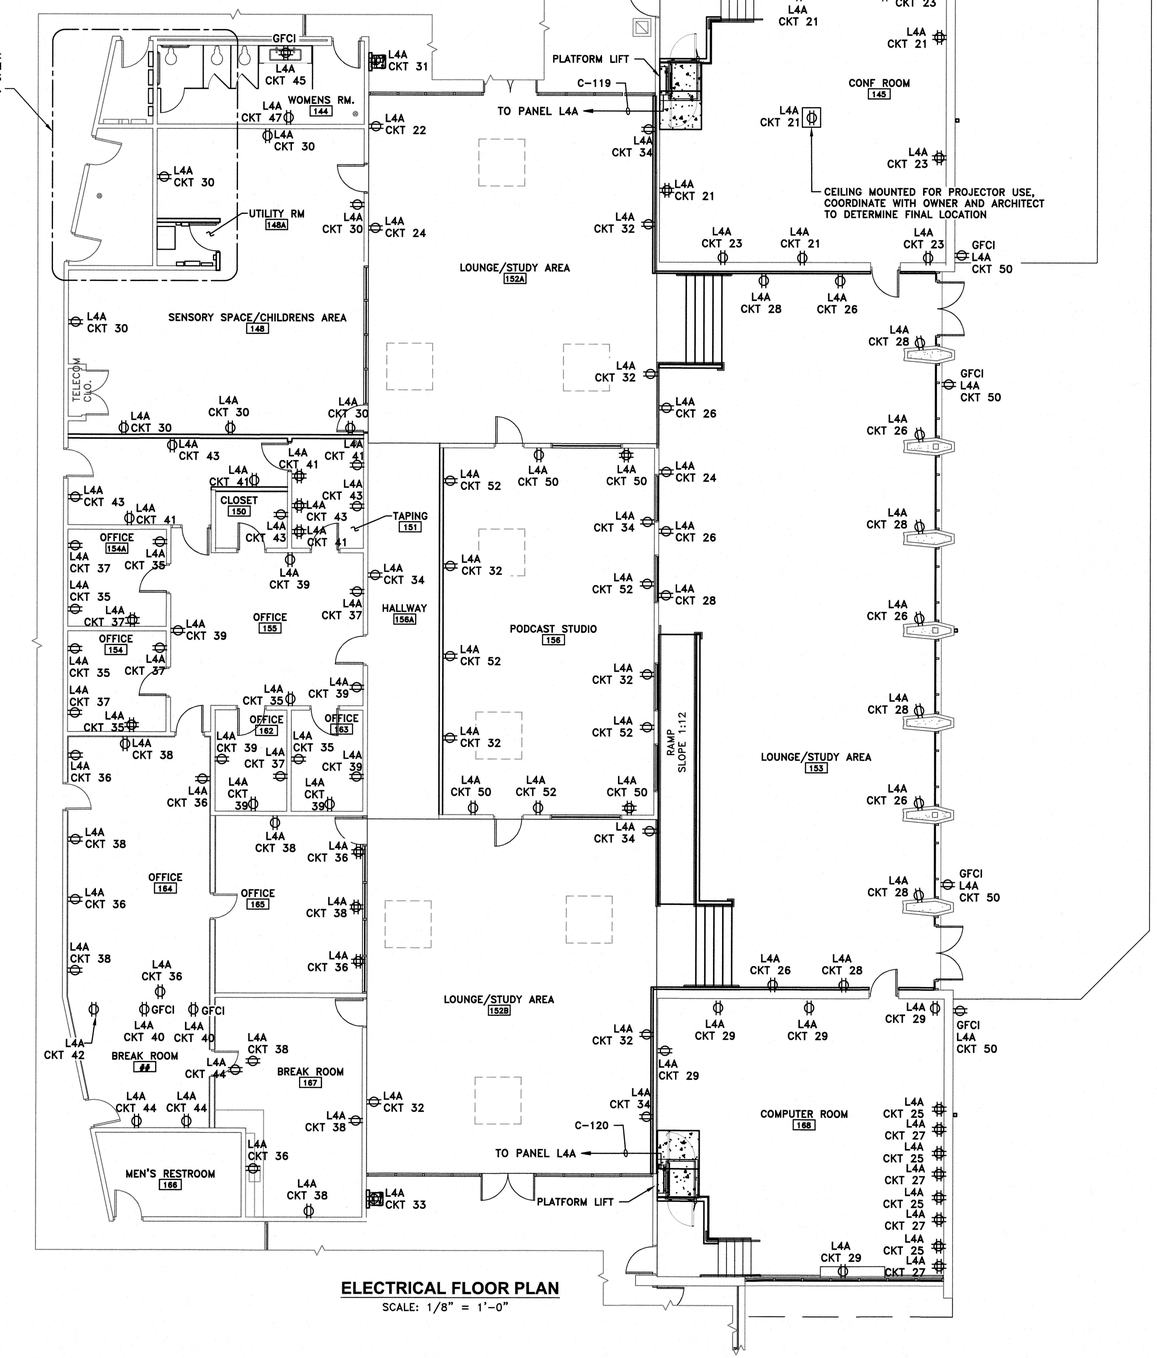

ELECTRICAL FLOOR PLAN
SCALE: 1/8" = 1'–0"

100% DRAWINGS-8-10-2026

APPROVED 11.12.26
William R. Long
PROFESSIONAL ENGINEER
NEW JERSEY LICENSE NO. 33012

APPROVED
Anita S. Aradhya
REGISTERED ARCHITECT
NEW JERSEY LICENSE NO. 18769

REVISIONS	DATE	BY
1 ADDENDUM NO. 5	11/11/26	KGK

Tri-State Architects, P.C. / Alaimo Group
WILLIAM R. LONG, P.E. LIC. 33012
ANITA S. ARADHYA, R.A. LIC. 18769
200 HIGH STREET MOUNT HOLLY, N.J.

DATE: AUG. 2026
DESIGNED BY: JRN/KMG
DRAWN BY: AA/KMG
CHECKED BY:
DEPT. HEAD:
CLIENT: WILLINGBORO TOWNSHIP
PROJECT LOCATION: WILLINGBORO TWP. BURLINGTON COUNTY NEW JERSEY
PROJECT NO.: M-0410-0011-000
CONTRACT NO.: BID#8-2026

KENNEDY CENTER RENOVATION TO THE SENIOR CENTER
ELECTRICAL FLOOR PLANS
SCALE: AS NOTED
SHEET E1
FILE NO.:

Plotted: 11/11/2026 10:43 AM Last saved: 11/11/2026 10:42 AM File Name: M:\Projects\M0410001100\Drawings\GLO-E1-EB-Electrical Plans.dwg